


T. 36S. R. 4 W. W. M.

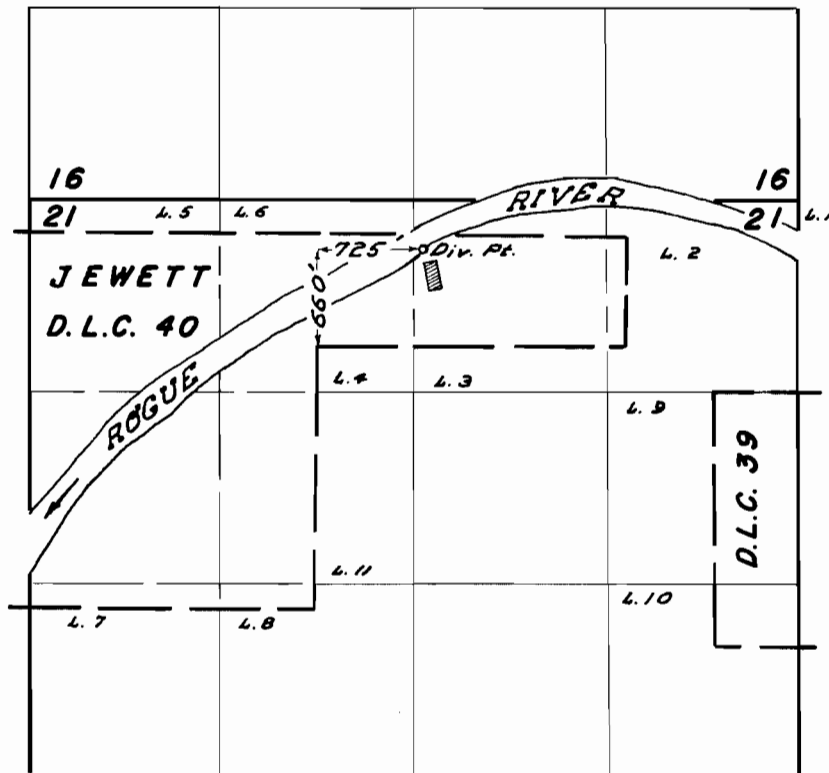

FINAL PROOF SURVEY
UNDER

TRANSFER J-33

Application No. Permit No.

IN NAME OF

EDWIN H. JENSEN

Surveyed JULY 19, 1965, by L. COLEBANK