


T. 32 S. R. 5 W. W. M.

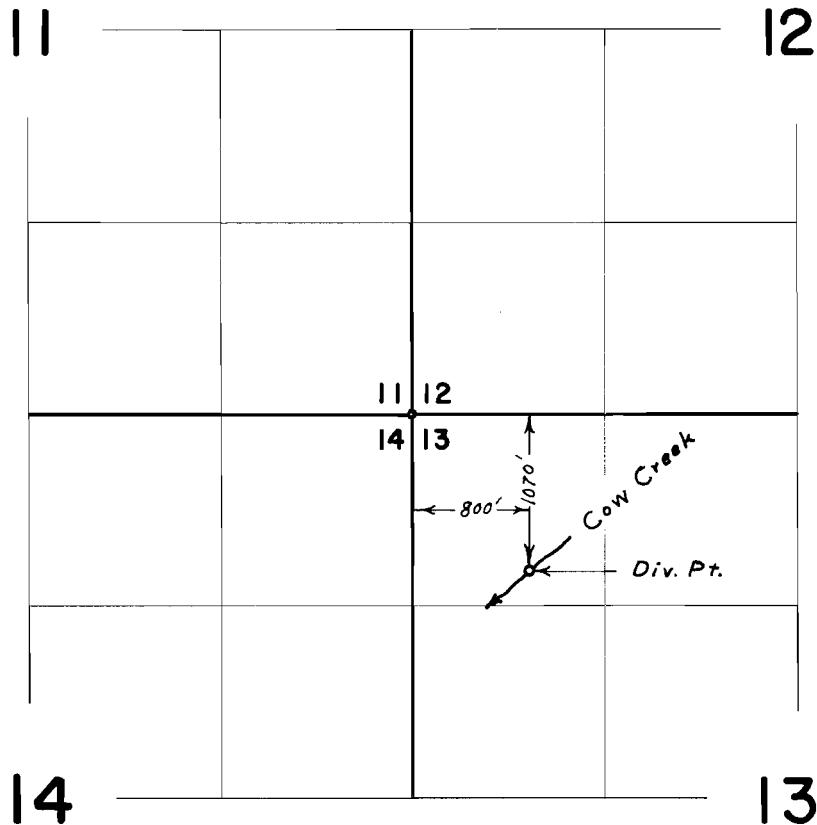

FINAL PROOF SURVEY
UNDER

Application No. _____ TRANSFER J-36
Permit No. _____

IN NAME OF

DALE R. JOHNS

Surveyed July 29, 1969, by L. E. Gould