


N

RECEIVED
JAN 2 1953

STATE ENGINEER
DIVISION OF SOILS

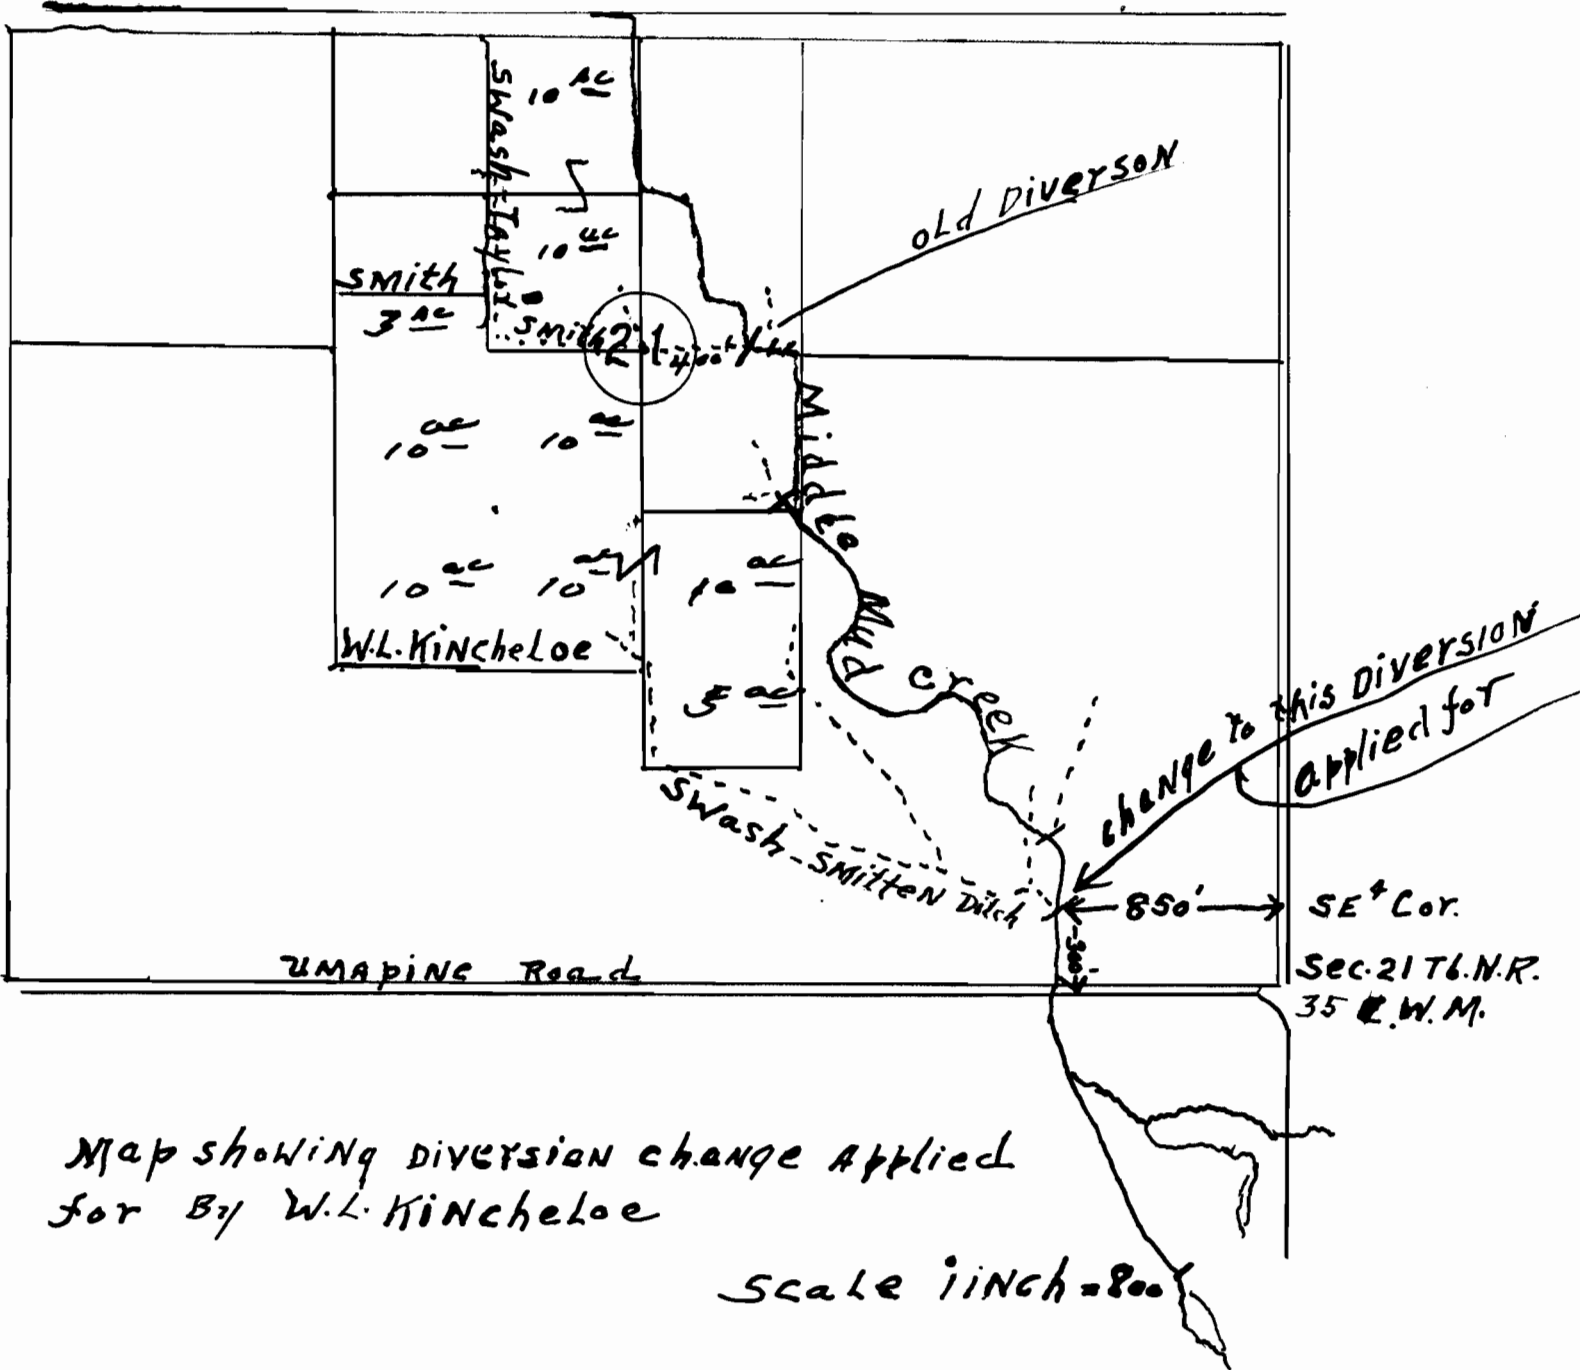

Map showing diversion change applied
for By W.L. Kincheloe

Scale 1 inch = 800'

K-15