T. 19S. R. 47 E.W.M.

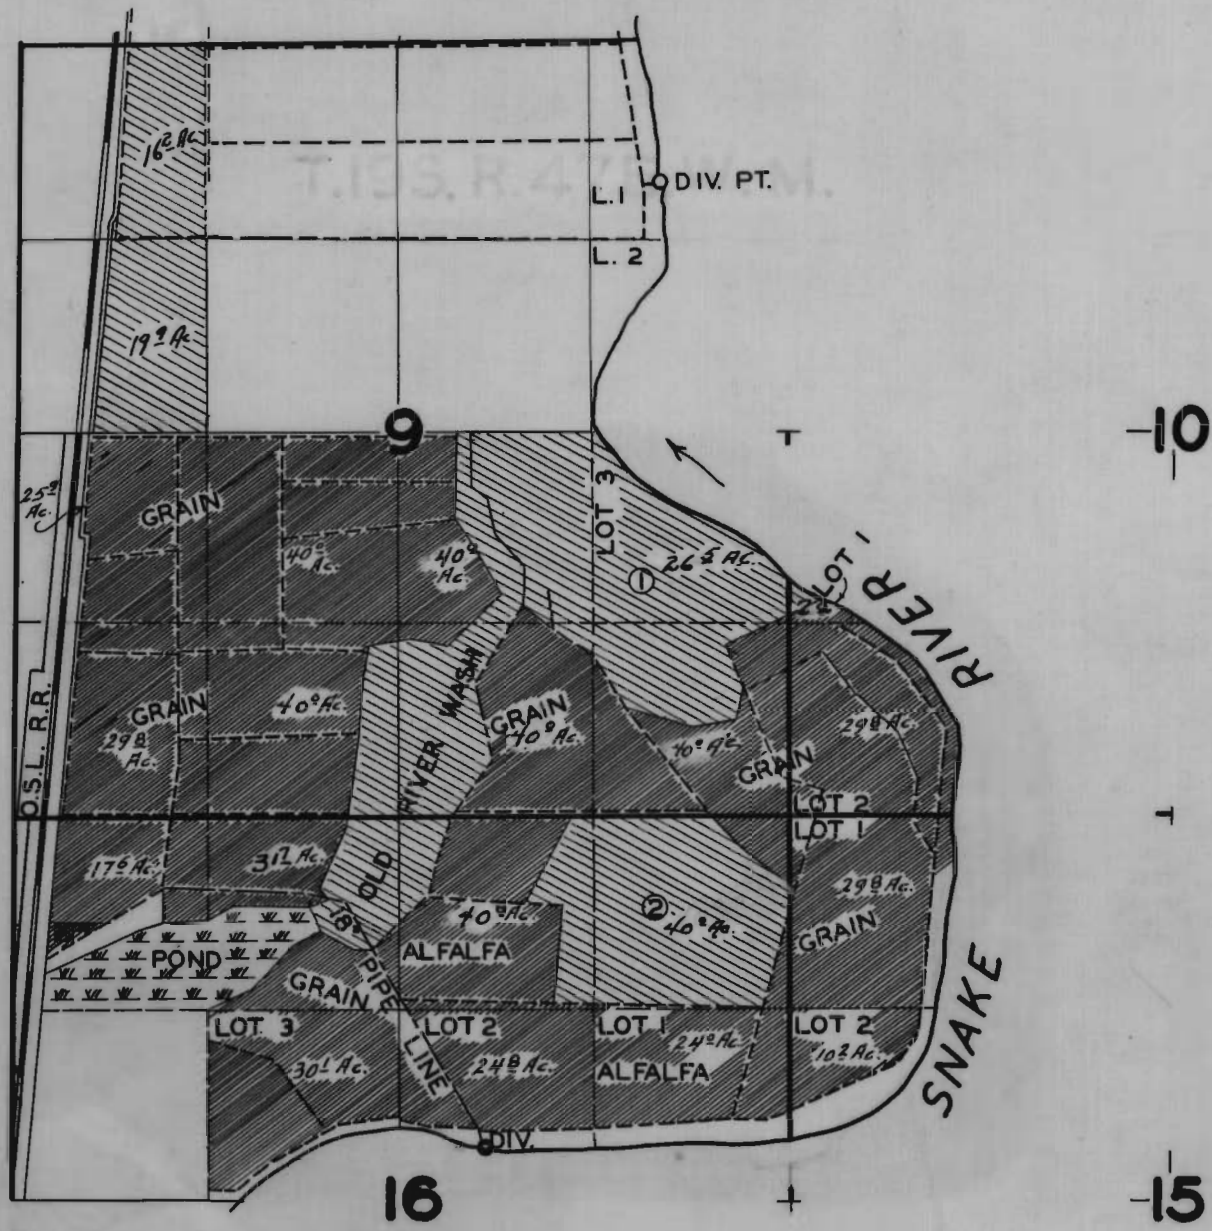

FINAL PROOF SURVEY

UNDER

Application No. 17199 Permit No. 12923

IN NAME OF

WILHEMINE KIESEL SHEARMAN & WILHEMINE KIESEL SHEARMAN – TRUSTEE

Surveyed JUNE 1, 1946, by

1946 – C