


T.40 S.R.7 W.W.M.

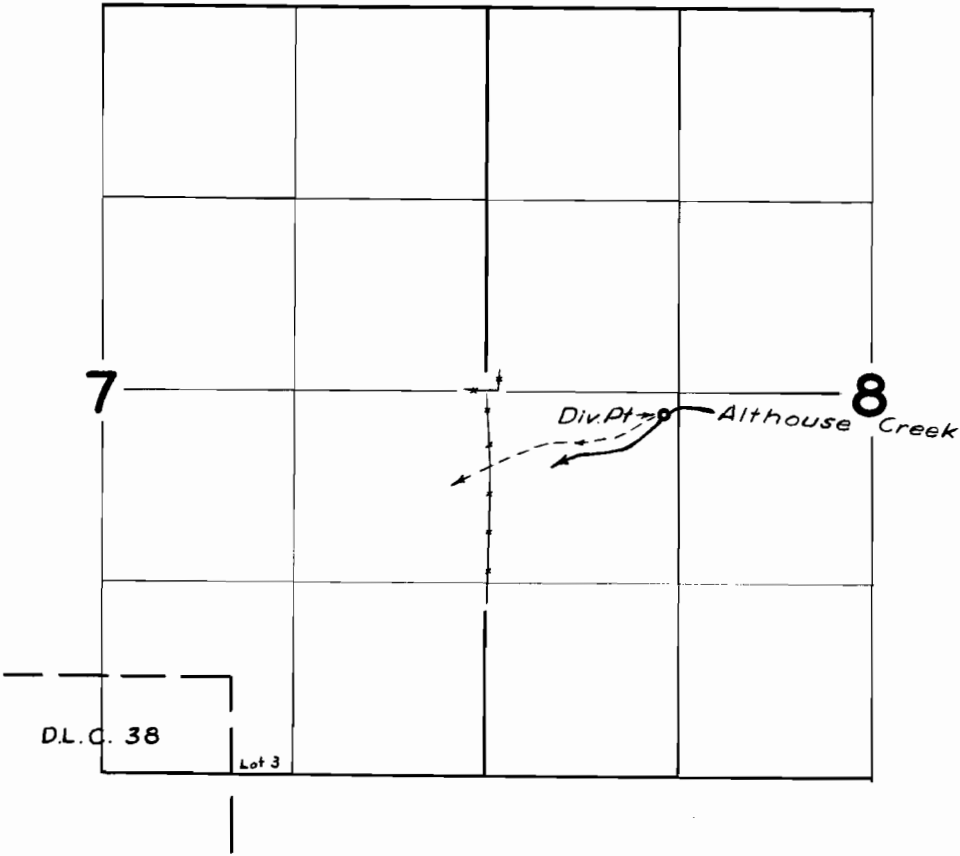

**FINAL PROOF SURVEY**  
UNDER

Transfer No. *K-20*  
Application No. \_\_\_\_\_ Permit No. \_\_\_\_\_  
IN NAME OF

Surveyed *16 July 1959*, by *M. Beck*