


T. 1N. R. 3W. W.M.

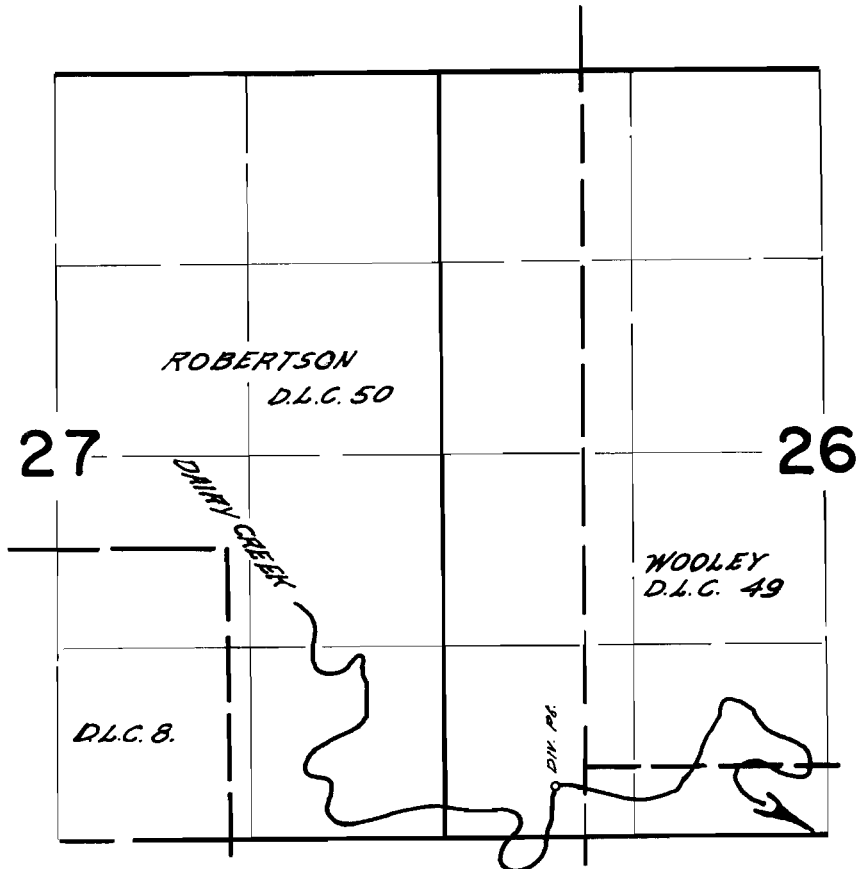

Diversion point located 120 Ft. S. & 210 Ft. W. from S.W. corner D.L.C. 49

FINAL PROOF SURVEY
UNDER

TRANSFER K-53
Application No. _____ Permit No. _____
IN NAME OF

CECIL N. KINDEL

Surveyed Oct. 10, 1968, by W. J. Ruppert