


T. 1N. R. 4W. W.M.

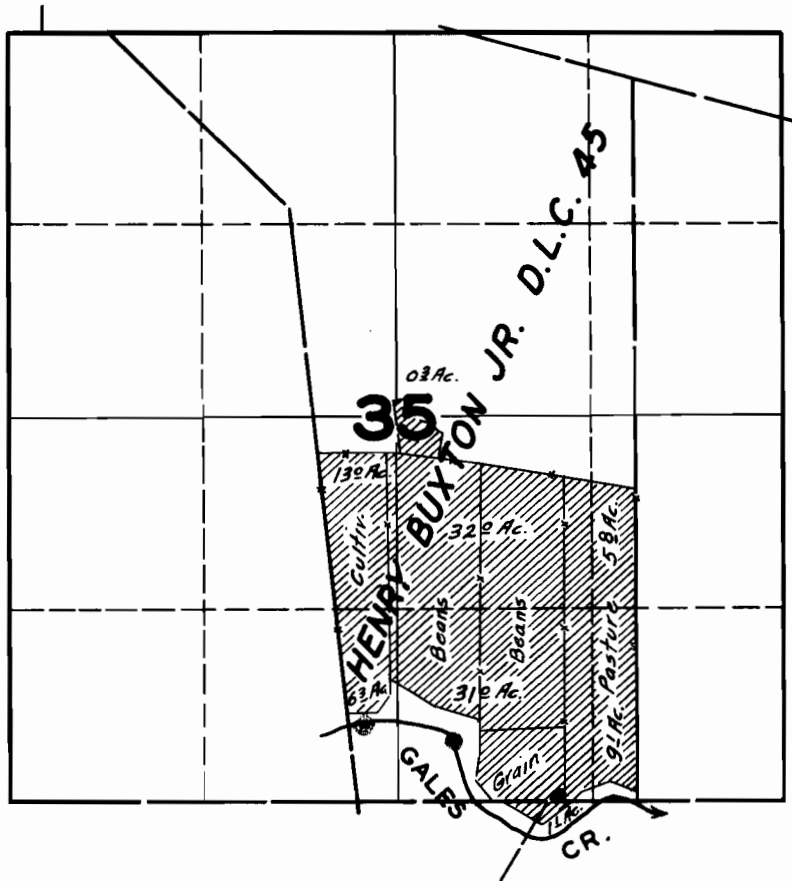

FINAL PROOF SURVEY UNDER

Application No. 17,888 Permit No. 13,583
IN NAME OF

E. A. RUETER

Surveyed JULY 2, 1947, by JAS. E. BUNNELL