


T. 7S. R. 1W. W.M.

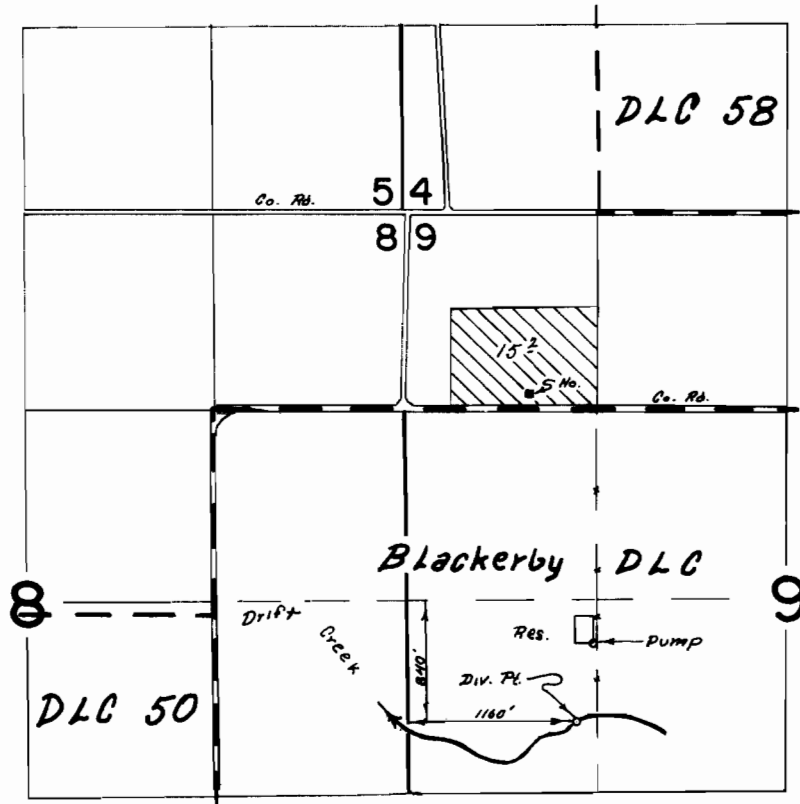

FINAL PROOF SURVEY UNDER

TRANSFER No. K-61
Application No. _____ Permit No. _____
IN NAME OF

..... GARY KAUFMAN

Surveyed June 29, 1973, by T.J. Paul