


T.17S.R.12E.W.M.

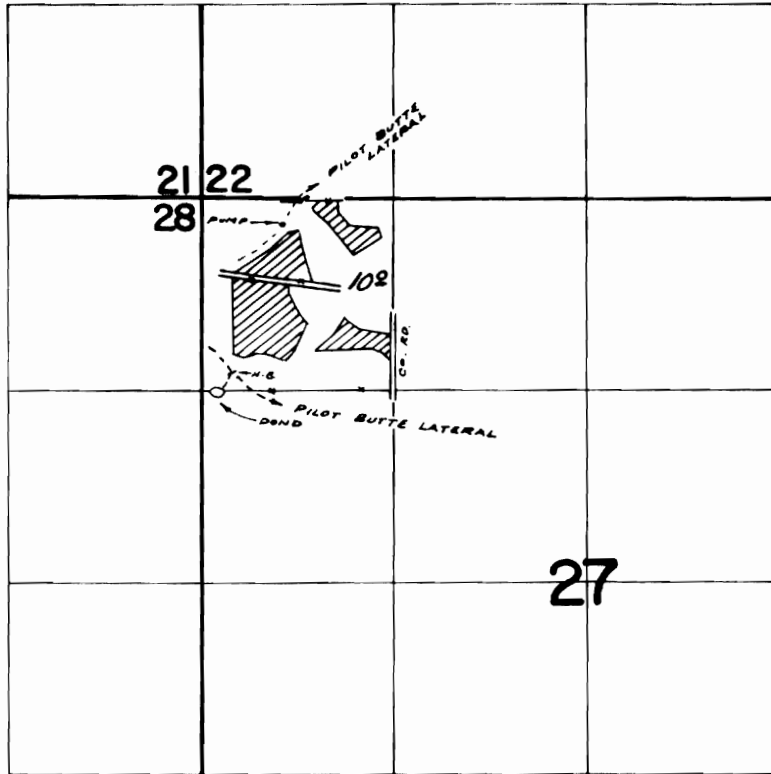

**FINAL PROOF SURVEY**  
UNDER

Transfer No. **K-43**  
Application No. .... Permit No. ....  
IN NAME OF

**RICHARD D. KERR**

Surveyed **MAR. 26. 27.** 19.70., by D. **BUELL**