


T.4S.R.39E.W.M.

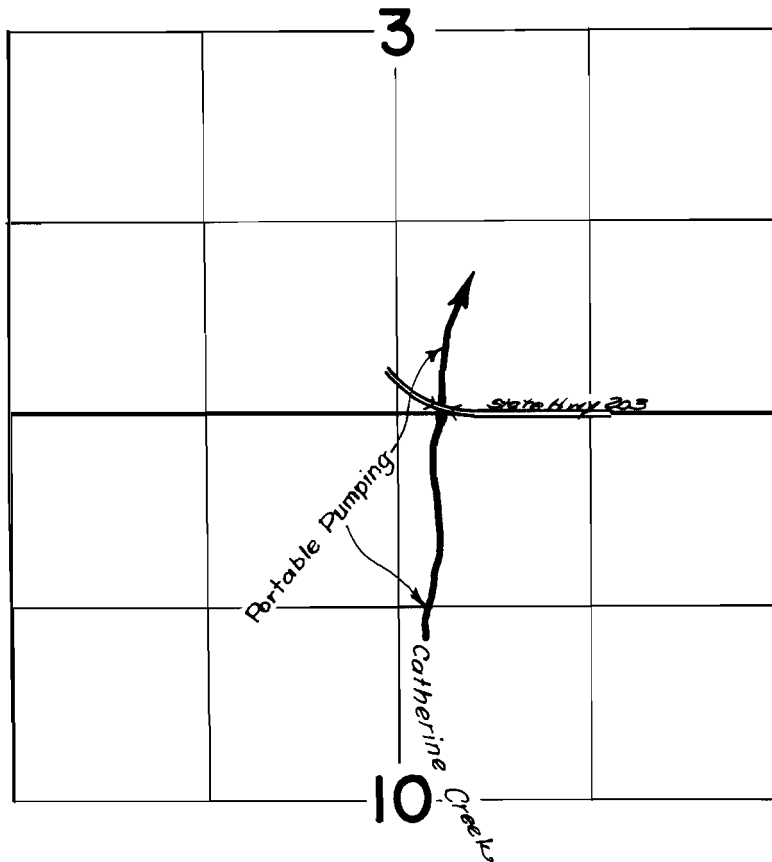

**FINAL PROOF SURVEY**  
UNDER

Transfer L-12

Application No. \_\_\_\_\_ Permit No. \_\_\_\_\_  
IN NAME OF

..... **HENRY L. HESS** .....

Surveyed Sept. 30 1963, by C. R. Baker...

*Handwritten mark*