


T.1N.R.4W.W.M.

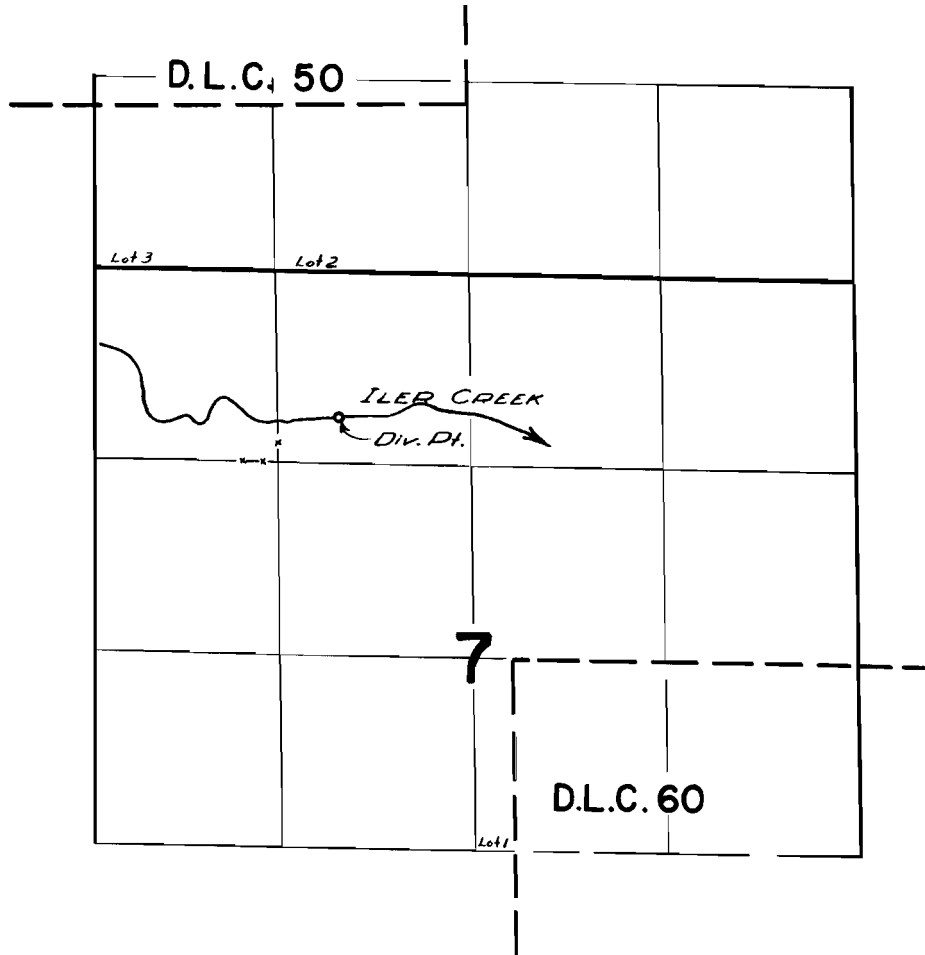

FINAL PROOF SURVEY
UNDER

Transfer No. L-23
Application No. _____ Permit No. _____
IN NAME OF

ROBERT B. LILLY

Surveyed *14 AUG.* 1961, by *M. Bish*