


TRANSFER L-40
A.L. Lemko to A.C. Kirtsis
BEND Auto Park.
2 ACRES

RECEIVED
DEC 16 1952
STATE ENGINEER
SALEM, OREGON

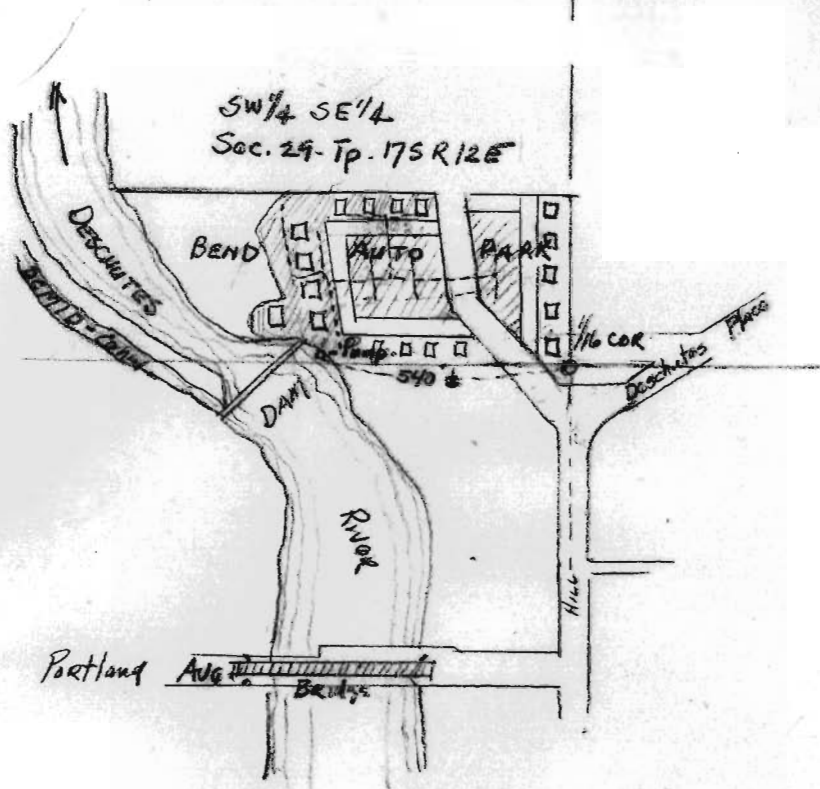

dec 12/16/52