RE: Roy R. Leonard & Leola M. Leonard
Application for Change of Method of Use

This is a tracing of the Soil Conservation aerial map, showing the premises involved in said application. Said tracing was made by H. E. Dixon of LaGrande, Oregon.

H. E. Dixon
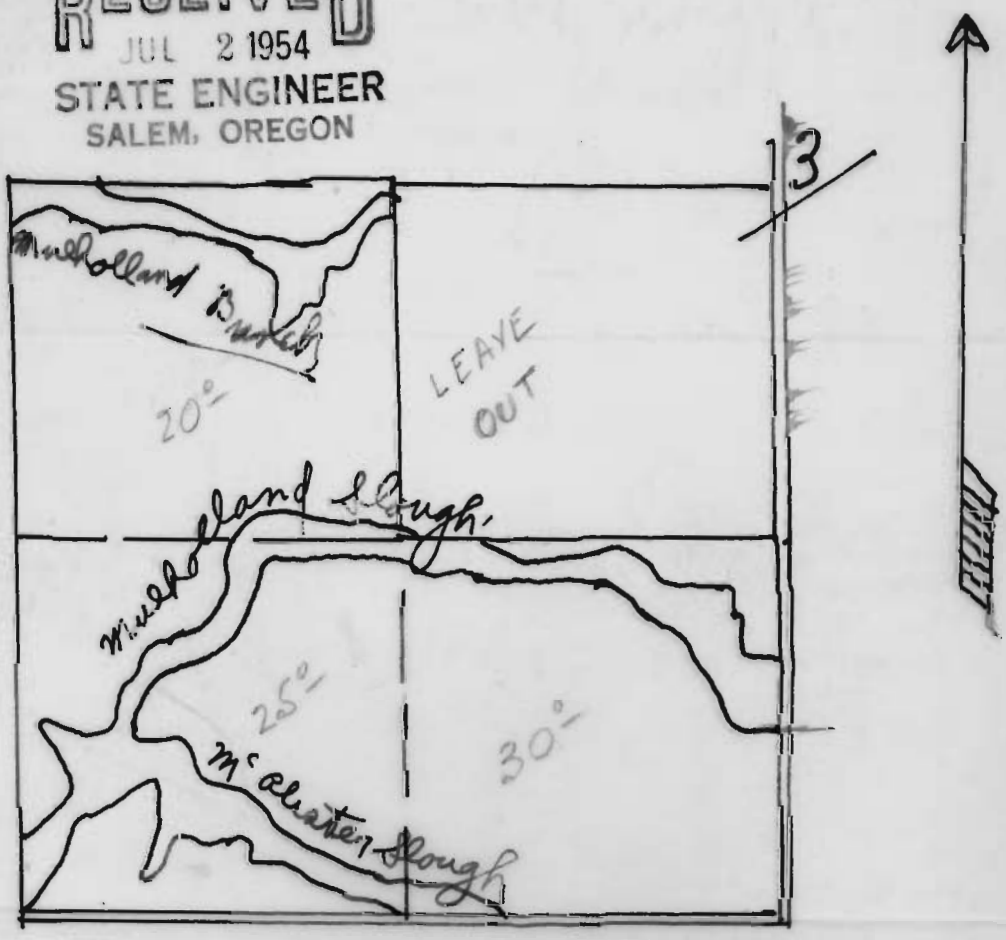
RECEIVED
JUL 2 1954
STATE ENGINEER
SALEM, OREGON