


TWP 39 S R 7 W W M

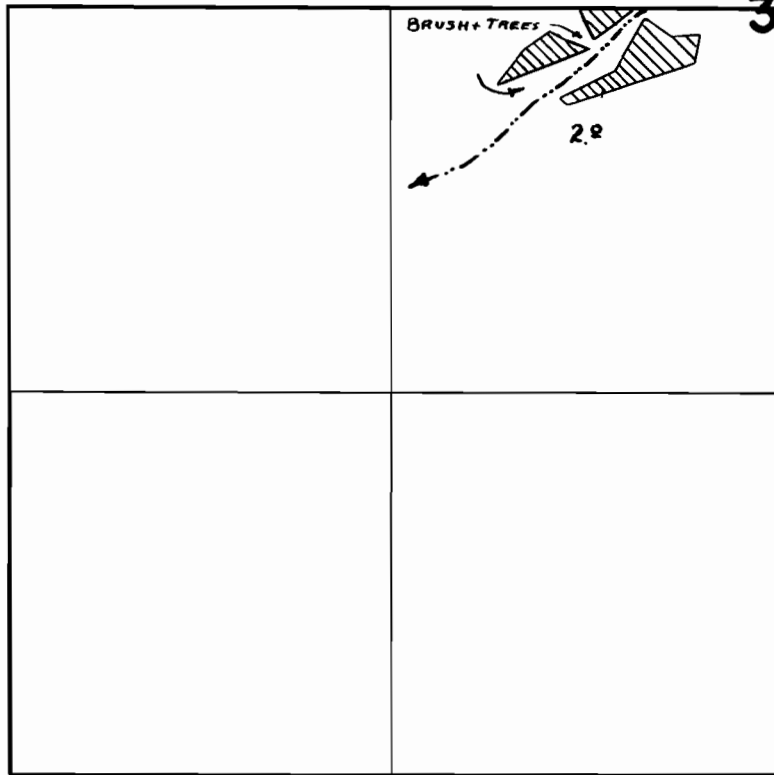

SW 1/4 SEC 33

FINAL PROOF SURVEY
UNDER

Transfer
Application No. L-57 Permit No.
IN NAME OF

FRANK M LOOSELY

Surveyed 6-27 1963, by R Steimer