


T. 1 S. R. 13 E. W.M.

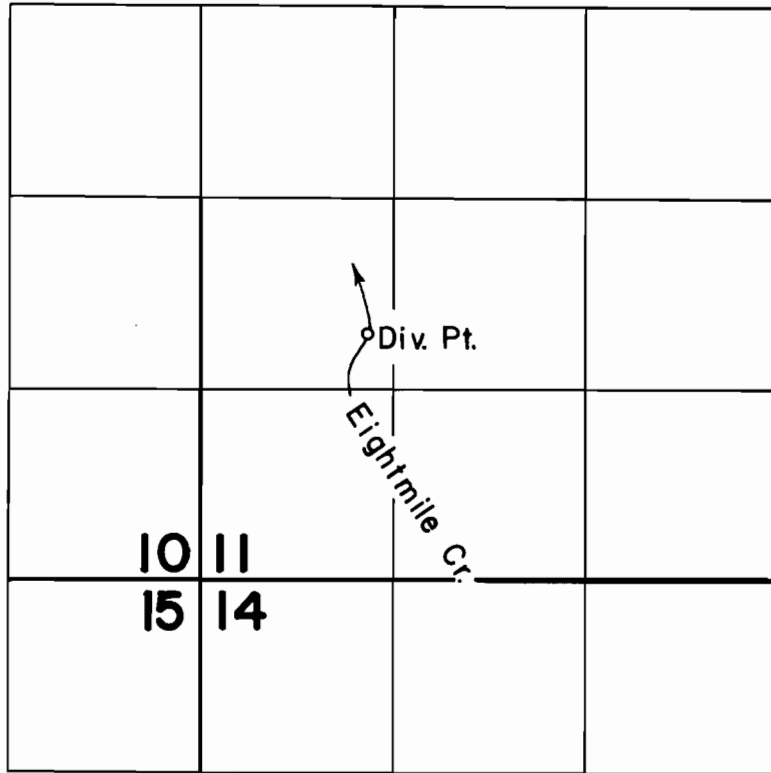

**FINAL PROOF SURVEY**  
UNDER

Transfer No. L-64  
IN NAME OF

..... **MILES C. LEABO** .....

Surveyed Dec. 11, 1962, by *L. W. Johnson*