


T17S R12E Sec 14

**RECEIVED**

DEC 7 1983  
WATER RESOURCES DEPT:  
SALEM, OREGON

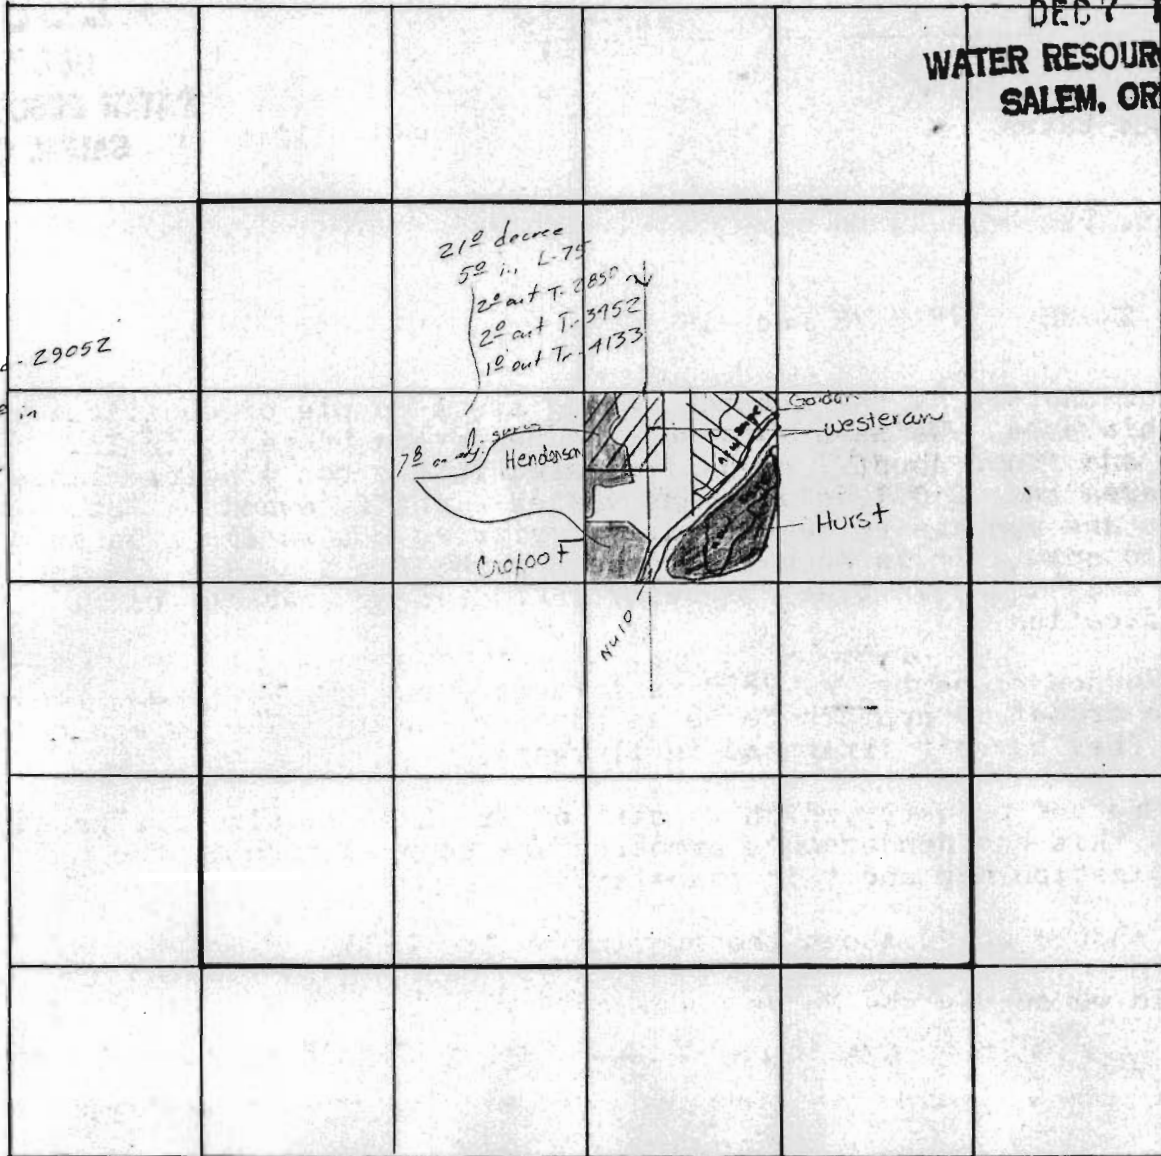

decree 8<sup>o</sup> - 2905Z  
Tr L-75 50 in  
T-2850 50 in

— vested right = 8 acres

//// TR L-75  
supposed to be 5 acres  
but scales out to 6

/// TR 2850 5 Acres

— Area COI claims  
is in - 8 Acres

**FINAL PROOF SURVEY**  
UNDER

Application No. .... Permit No. ....  
IN NAME OF

.....  
Surveyed ..... 19....., by .....