


T.14 S. R.39 E. W.M.

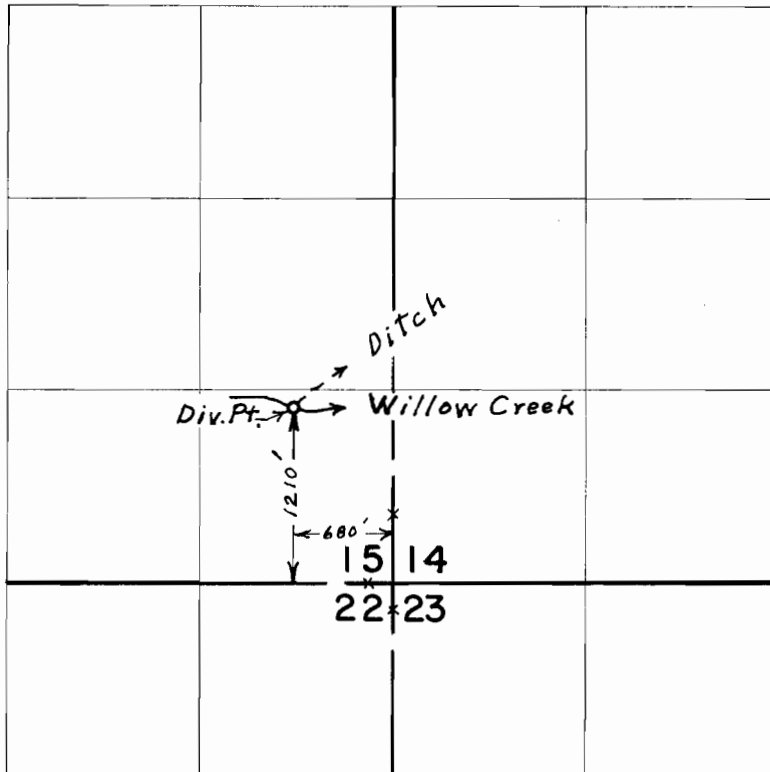

FINAL PROOF SURVEY
UNDER

Application No. _____ Transfer No. L-76
Permit No. _____
IN NAME OF
LOCEY & SON

Surveyed April 24, 1975, by L. E. Gould