


T.17S.,R.14E.,W.M.

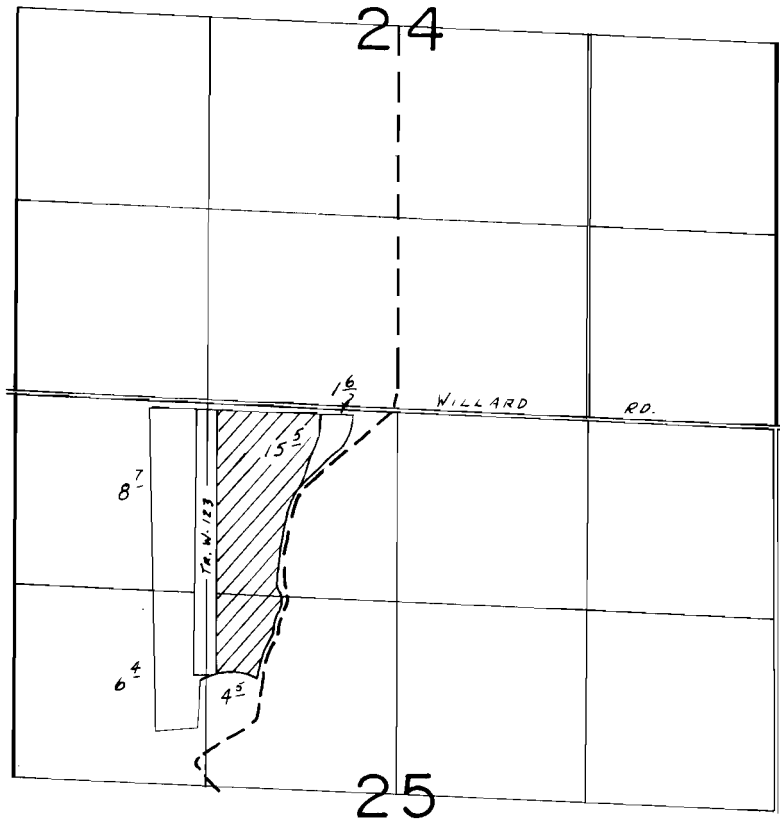

SCALE: 1"=1320'

FINAL PROOF SURVEY
UNDER

Transfer No. L-81

IN NAME OF

.....LEE & ANN RHOADS.....

Surveyed June 19... 19.84, by L. G. OLSON.....