


T. 2 S. R. 12 & 13 E. W. M.

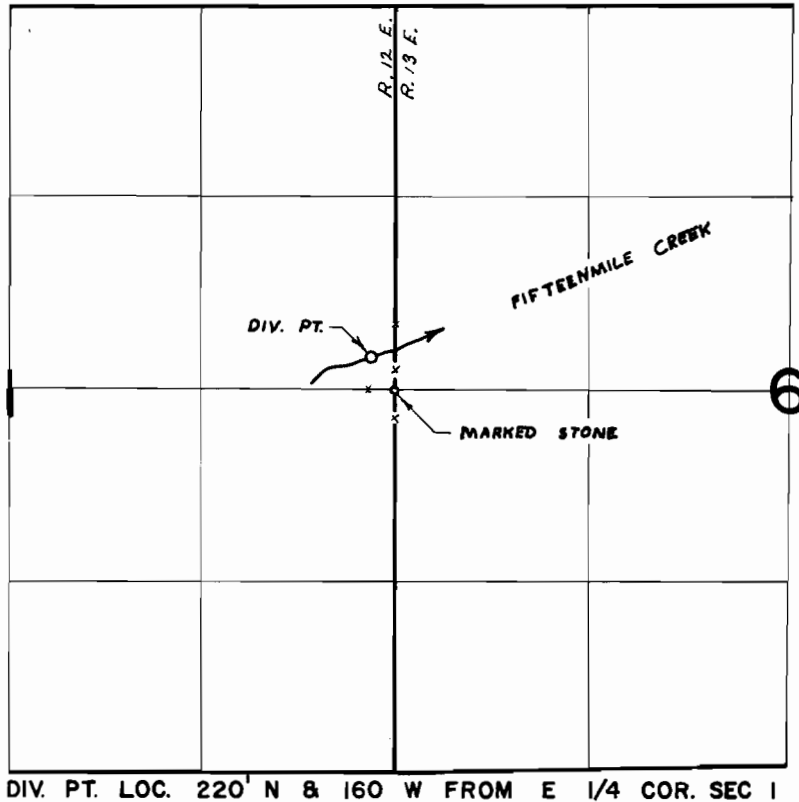

FINAL PROOF SURVEY
UNDER

Application No. _____ Transfer Nos. L-88 & L-98
Permit No. _____
IN NAME OF

PRESTON & LILLIAN LINDHORST.

Surveyed NOV. 5, 1971, by R. MUCKEN.