


# T.12 S.R.5 & 6 W.W.M.

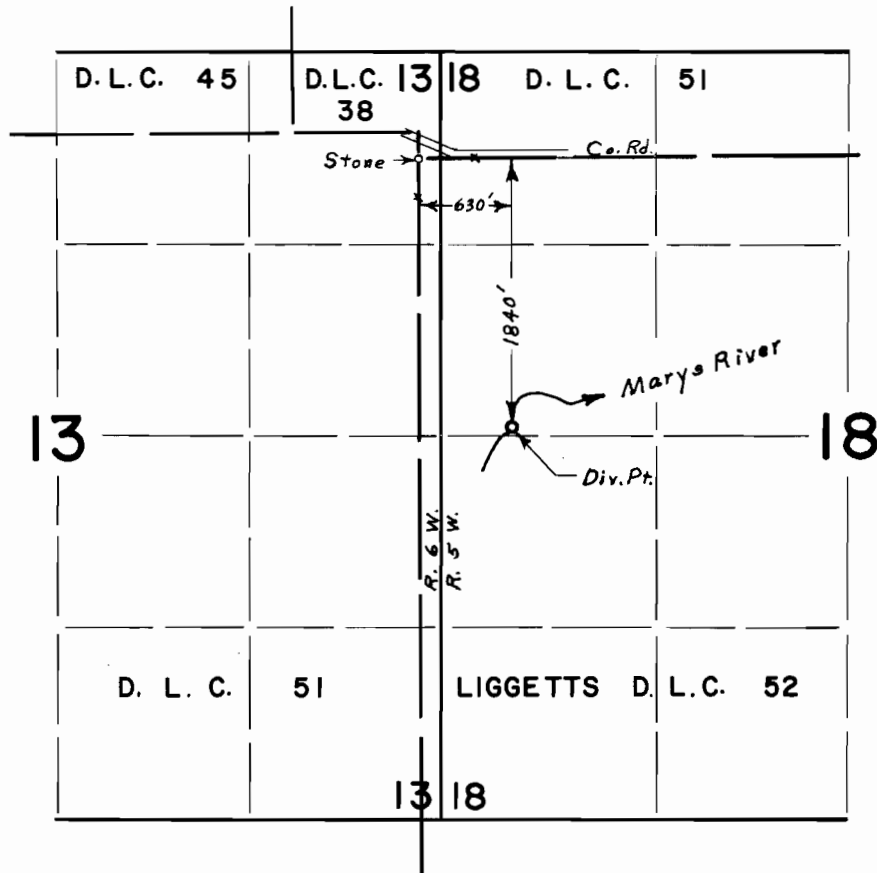

## FINAL PROOF SURVEY UNDER

Application No. \_\_\_\_\_ TRANSFER L-92  
Permit No. \_\_\_\_\_

IN NAME OF

**WILLIAM LEINER**

Surveyed July 1, 1969, by L. E. Gould