


T. 182 S., R. 31 E., W.M.

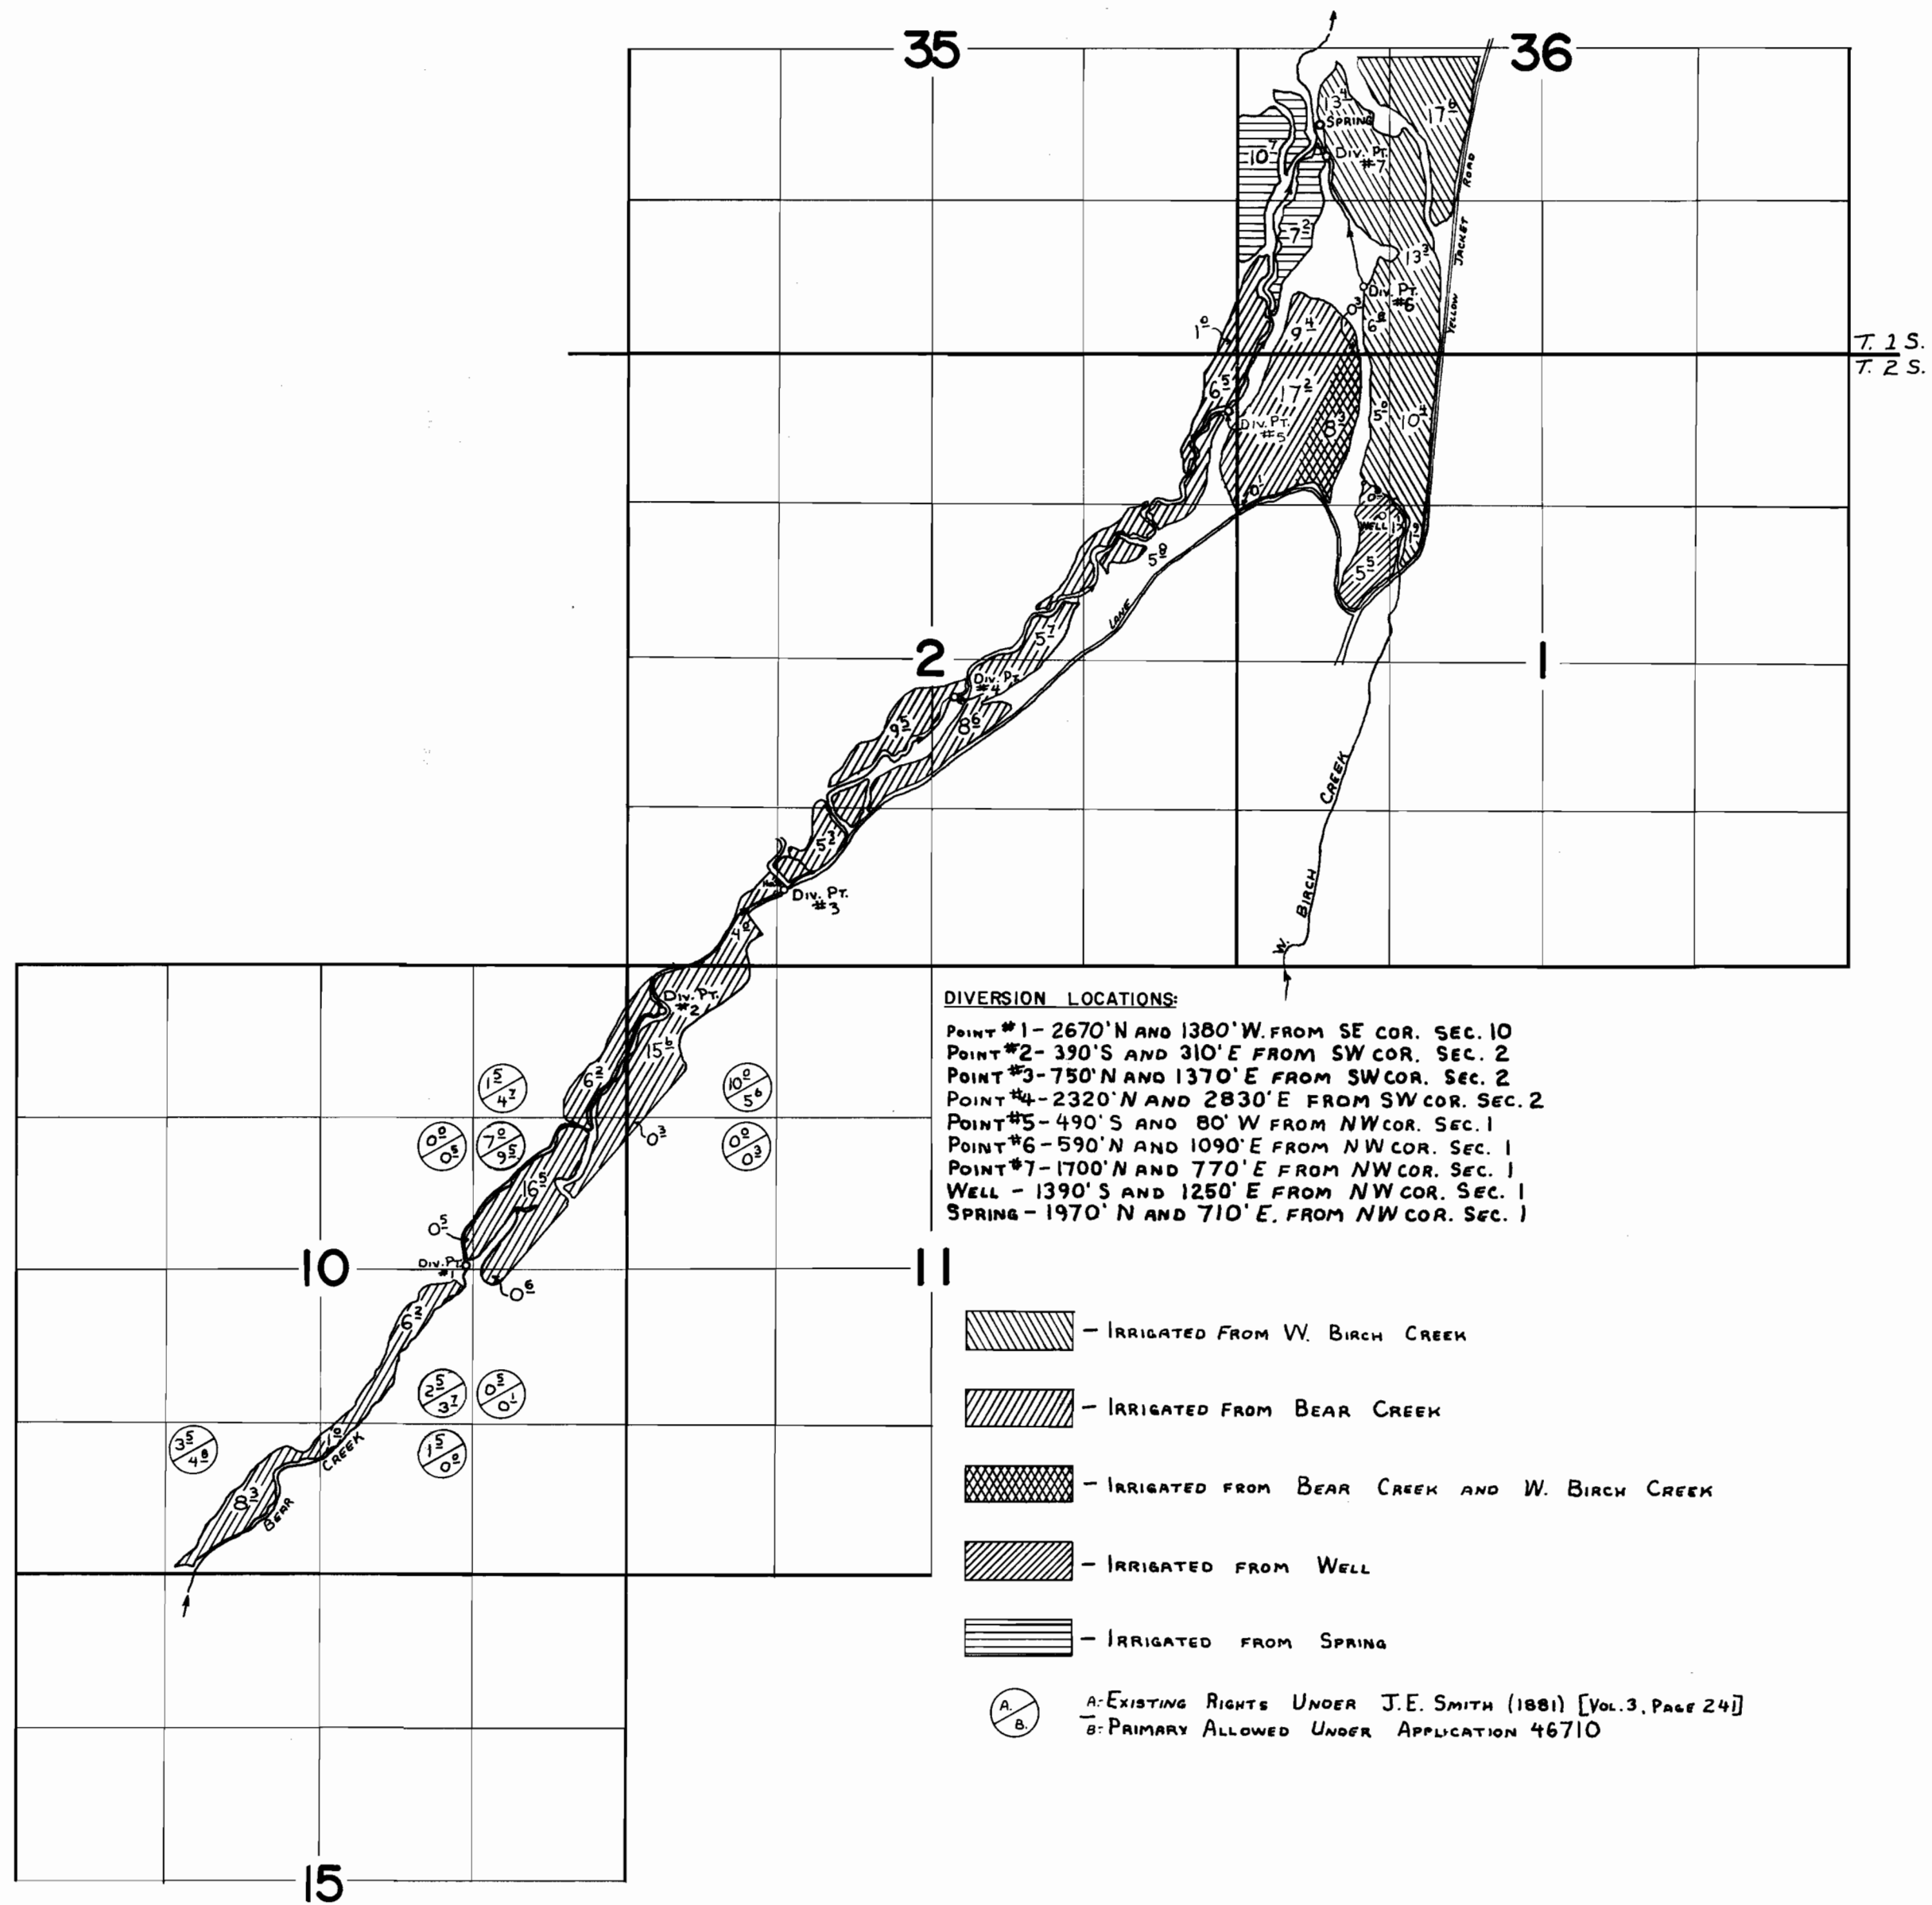

**FINAL PROOF SURVEY
 UNDER**

Transfer No. L-101
 Application No. 46710 Permit No. 34906
 IN NAME OF

ARTHUR C. NICOSON & R. A. LOW
 and

Application No. 39292 Permit No. 29261
G-4860 G-4575
 IN NAME OF

R. A. LOW

Surveyed Aug. 6, 1974, by J. TOLL