


T.5S.R.39E.W.M.

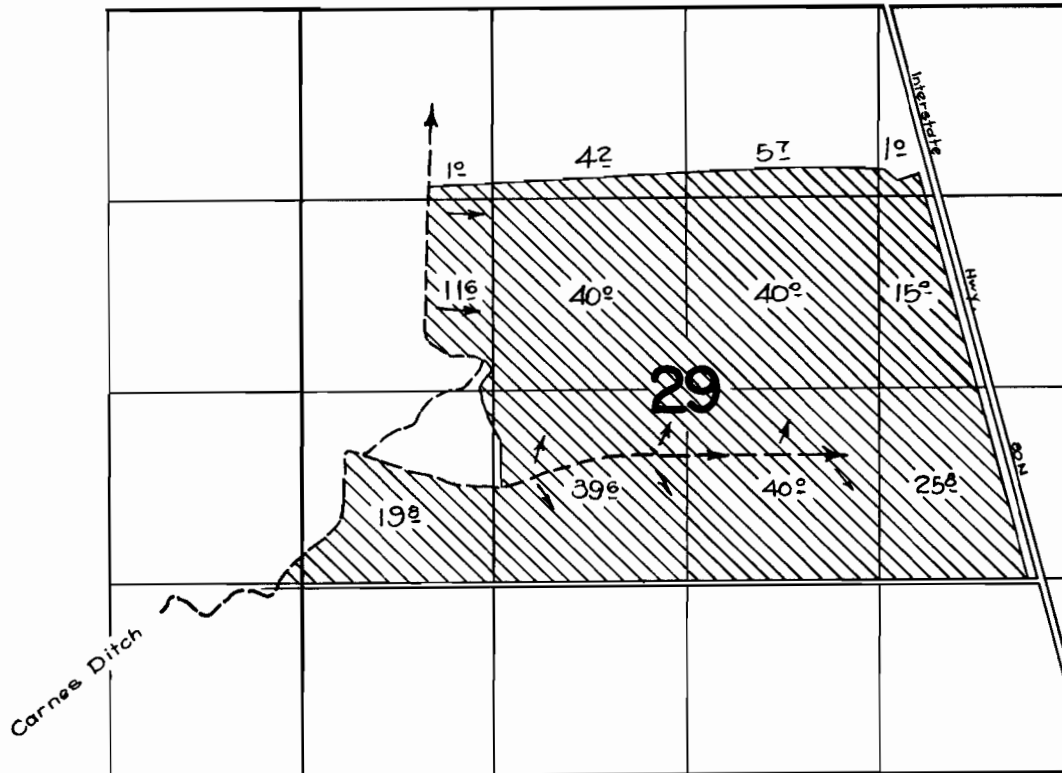

FINAL PROOF SURVEY UNDER

TRANSFER NO. M-51

Application No. _____ Permit No. _____
IN NAME OF

..... E. R. M^c CANSE

Surveyed Oct. 2, 1963, by C. R. BAKER.