


T.39S. R.8 W.W.M.

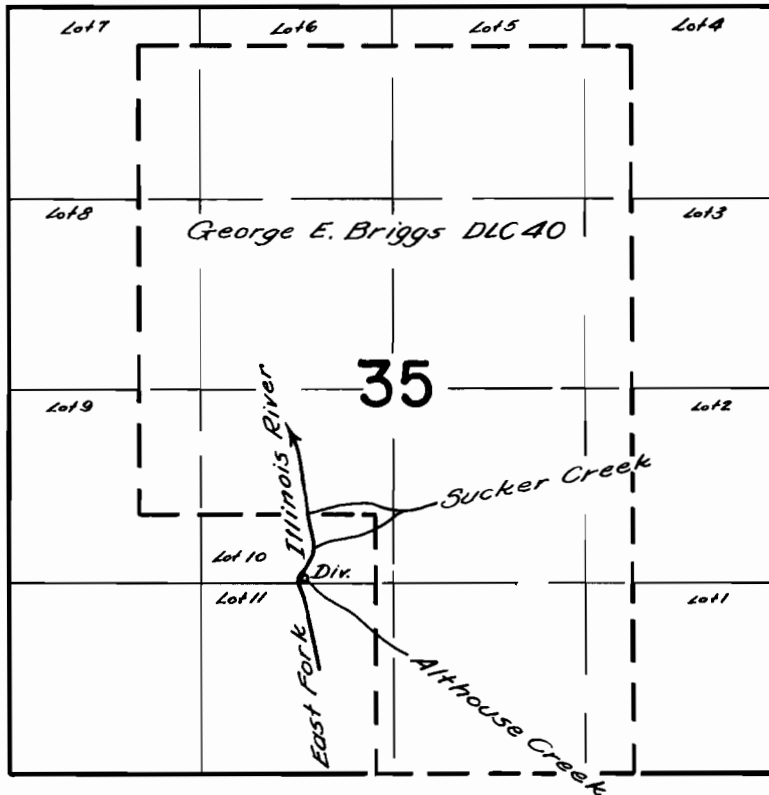

FINAL PROOF SURVEY UNDER

Application No. M-56 Permit No. _____
IN NAME OF

GEORGE P. MARTIN

Surveyed April 19, 1961, by C. O. Burt