



R21E

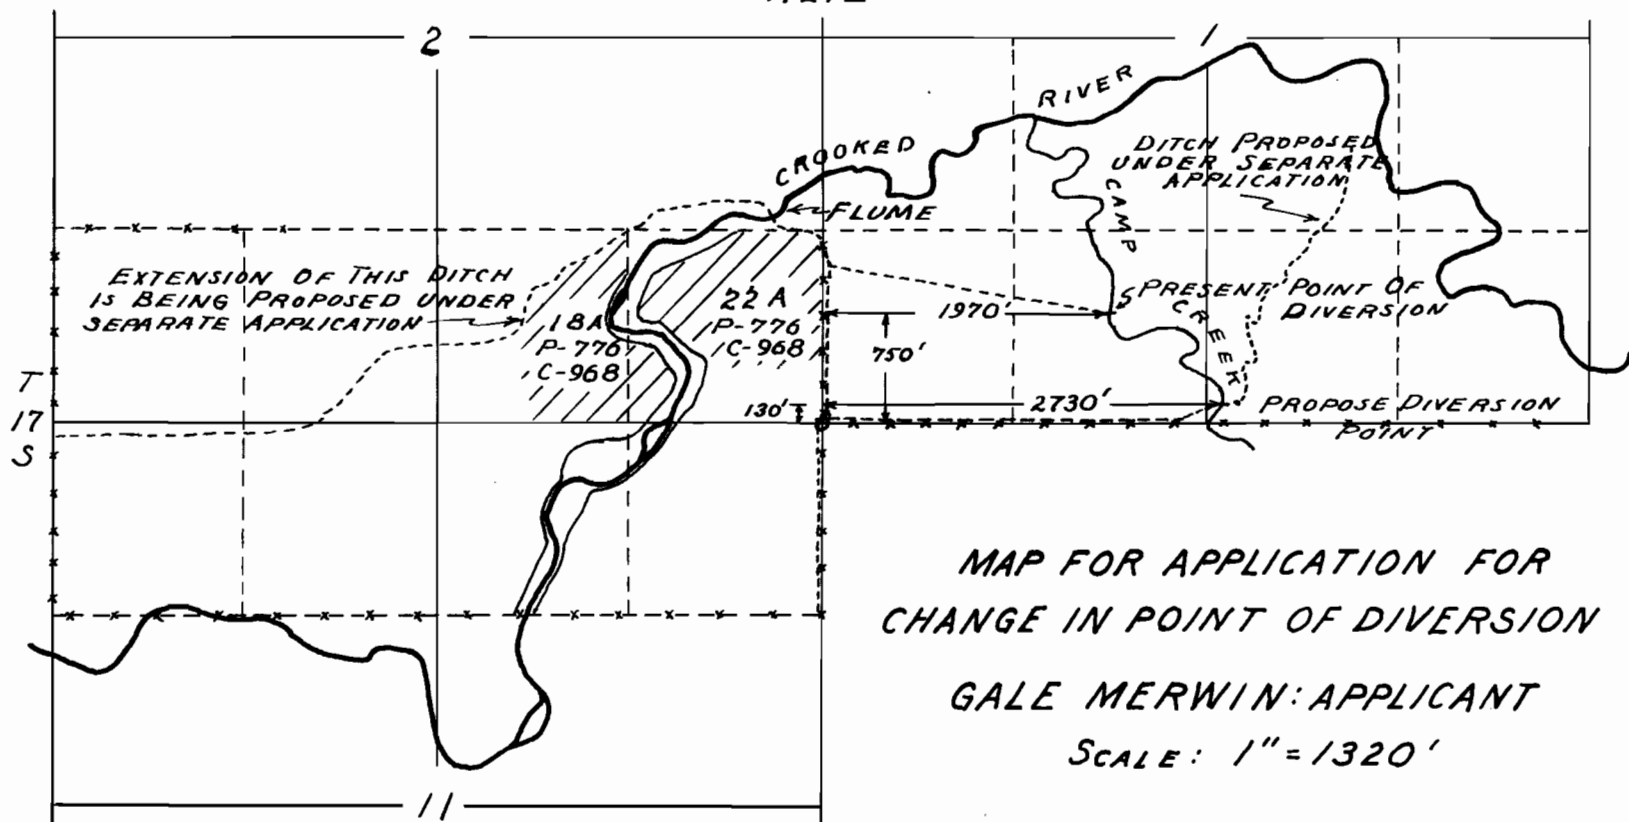

I, FRED D. GUSTAFSON, OF PRINEVILLE, OREGON DO HEREBY CERTIFY THAT THIS MAP WAS MADE FROM NOTES TAKEN DURING AN ACTUAL SURVEY MADE BY ME ON APRIL 8, 1952 AND ON JAN. 13 AND 14, 1953 TOGETHER WITH SUPPLEMENTAL DETAILS OBTAINED FROM AERIAL PHOTOGRAPHS TAKEN AUG. 10, 1951; THAT A DIRECT TIE WAS MADE BETWEEN THE DIVERSION WORKS AND THE CORNER COMMON TO SECTIONS 1, 2, 11, 12, T17S, R 21E, AS SHOWN.

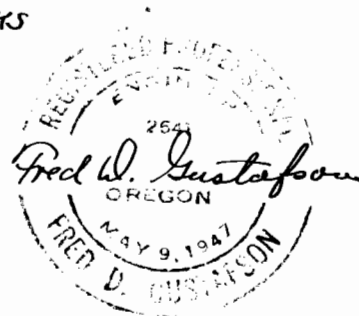

M-91