


T.3S. R.4E.W.M.

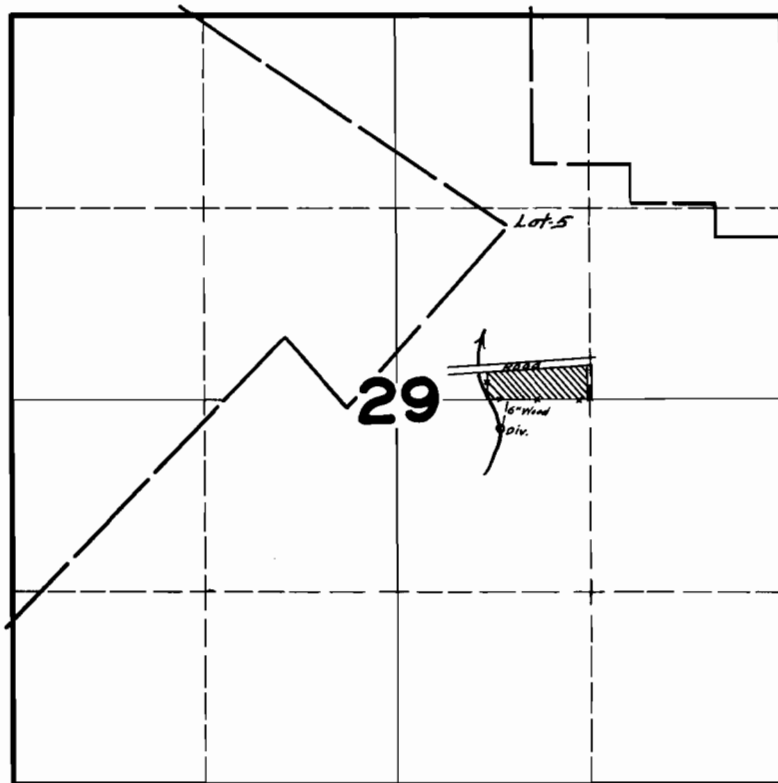

FINAL PROOF SURVEY UNDER

Application No. 19733 Permit No. 15303

IN NAME OF

HARRY L. OSBORNE & EVERETTE E. OSBORNE.

Surveyed SEPT. 6 1945, by *James B. Sumrell*