


T.6N. R.35E.W.M.

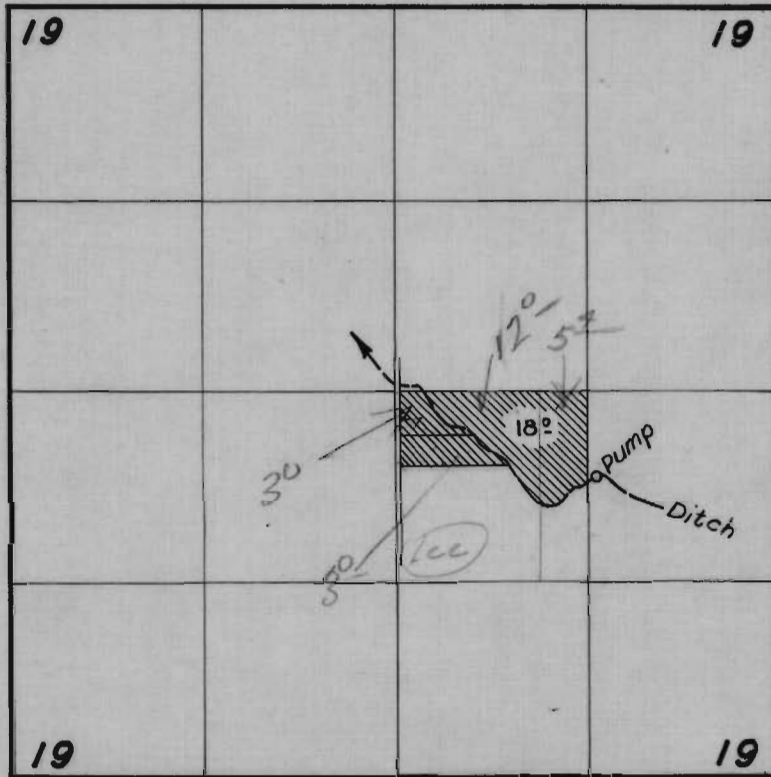

FINAL PROOF SURVEY
UNDER

Application No. M-108... Permit No.
IN NAME OF

J. E. MYERS

Surveyed 14. Nov. 1958, by C.O. Bartels