


T.6N.R.35&36E.W.M.

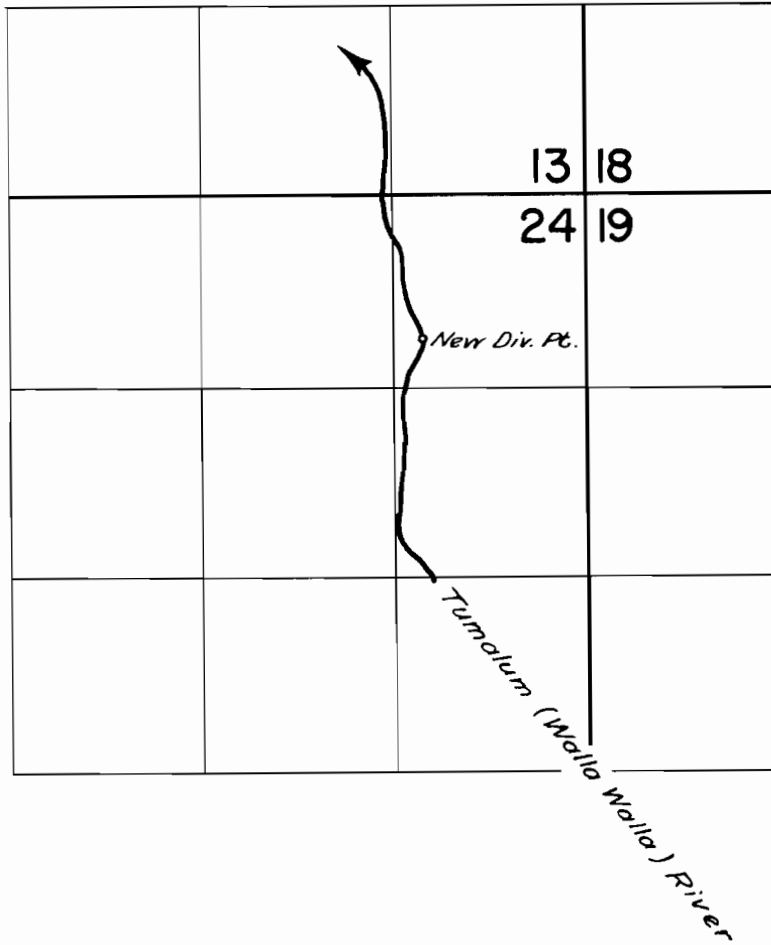

**FINAL PROOF SURVEY**  
UNDER

**Transfer M-124**

Application No. .... Permit No. ....  
IN NAME OF

**HOWARD S. MURRAY**

Surveyed April. 30 1962, by *R. Jackson*