


T.18S.R.12E.W.M.

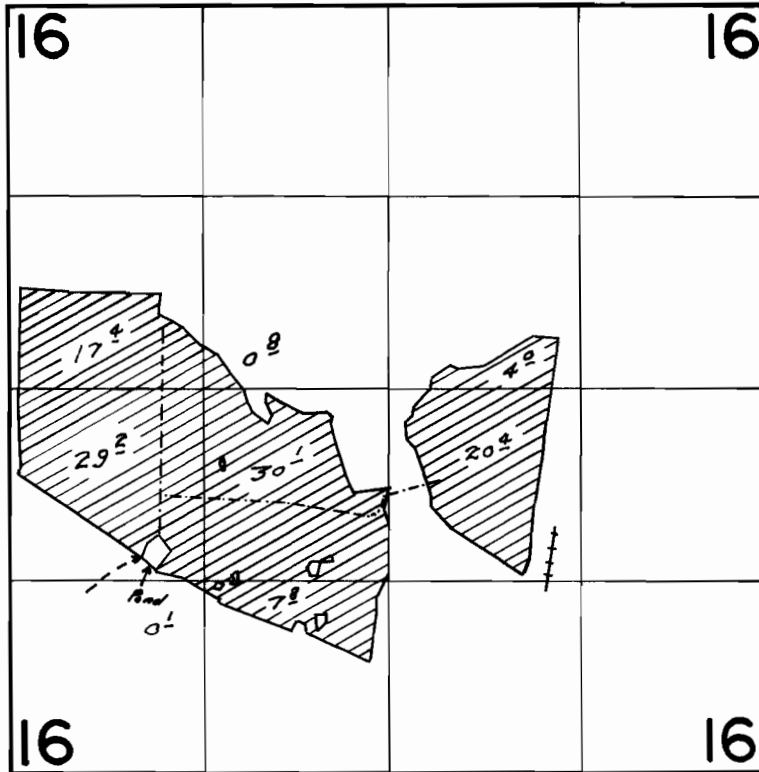

FINAL PROOF SURVEY
UNDER

Transfer No. M-127
Application No. _____ Permit No. _____
IN NAME OF

D. J. WARD

Surveyed August 23, 1965., by *Clayton J. Gardner*