


# T.88&9S.R.25E.W.M.

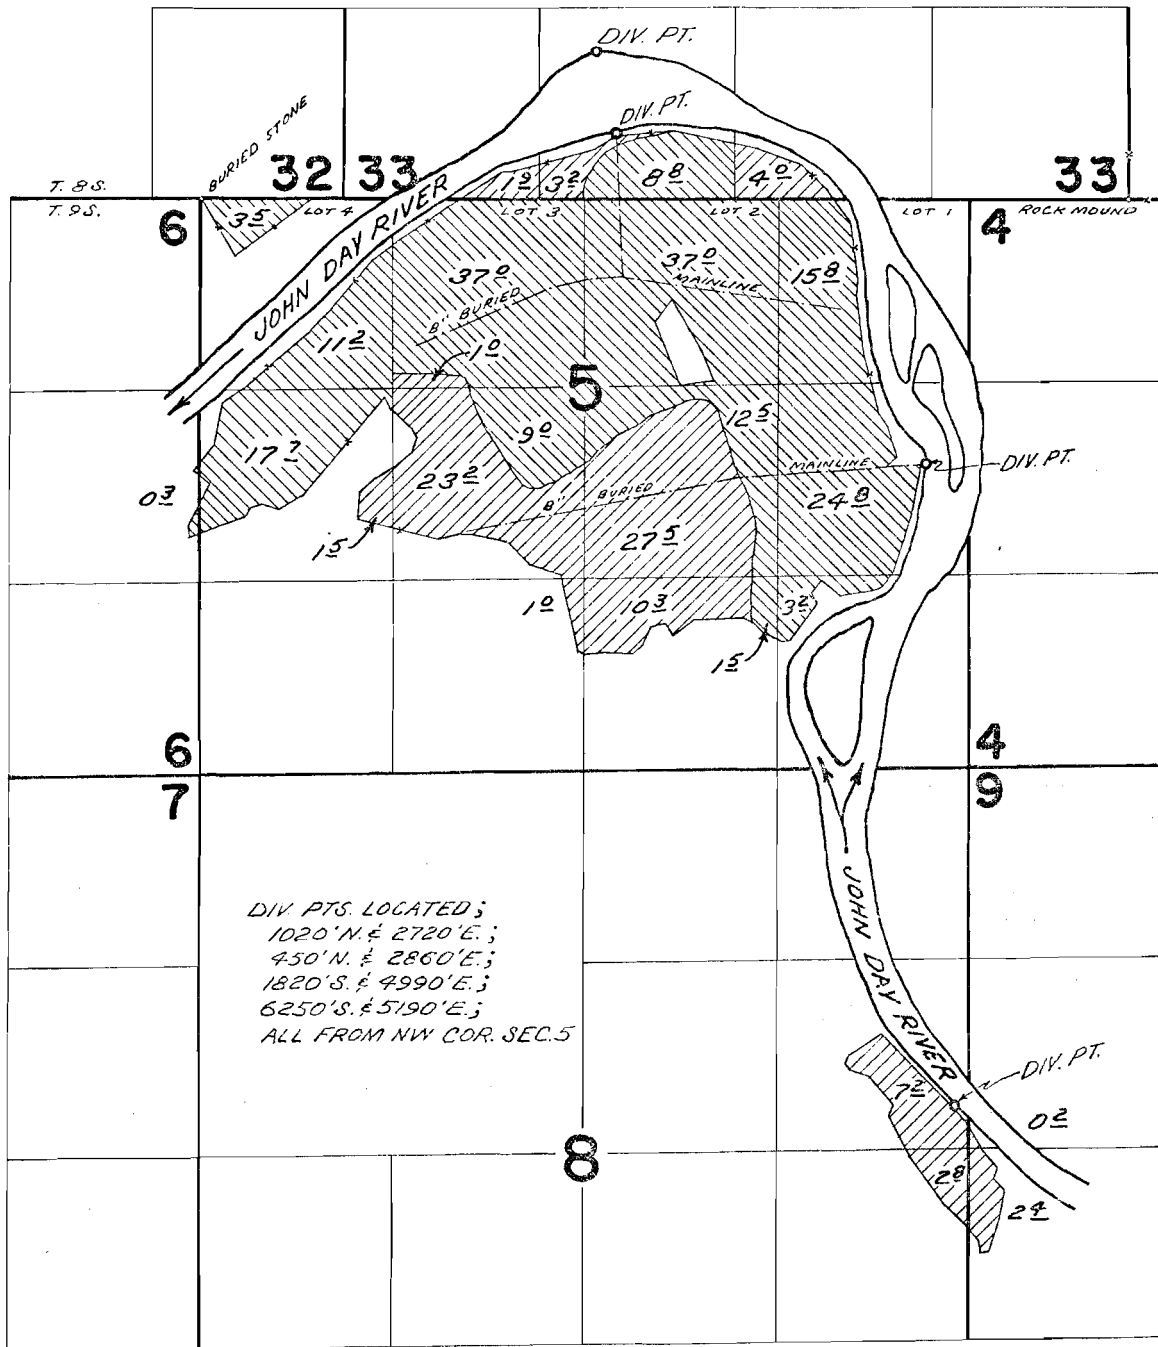

## FINAL PROOF SURVEY UNDER

TRANSFER No. M-165  
 Application No. 44149 Permit No. 32864



IN NAME OF

**ANDREW F. & MAXINE F. LECKIE**

Surveyed FEB 9-11 1970, by D. BUELL