


T.6N.R.35E.W.M.

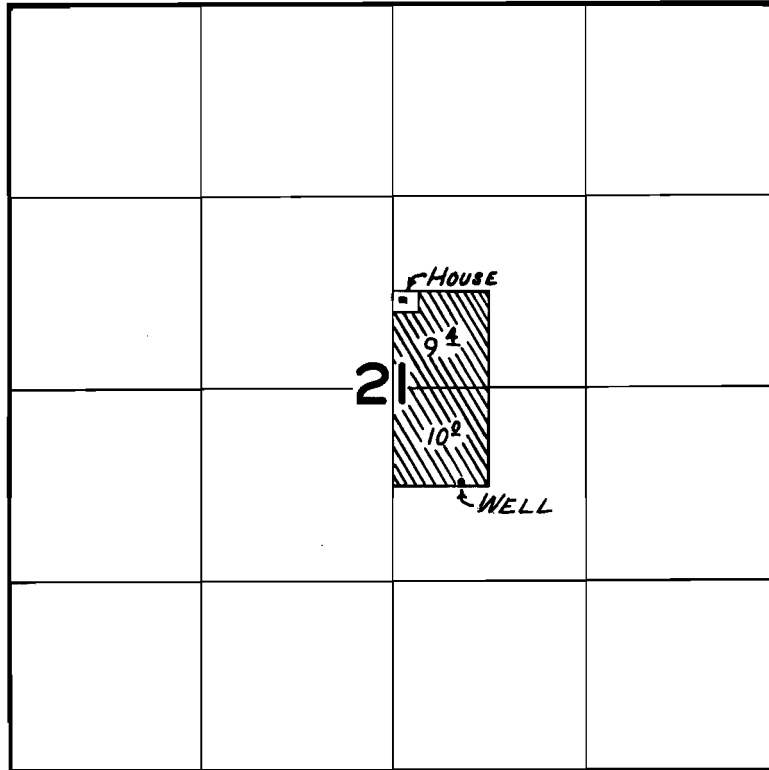

**FINAL PROOF SURVEY**  
UNDER

Application No. *G-957* Permit No. *G-857*  
IN NAME OF

*J. G. MERRIFIELD*

Surveyed *JULY 15 19.60*, by *M. BISH*

NZ-5F-105

*MS*