
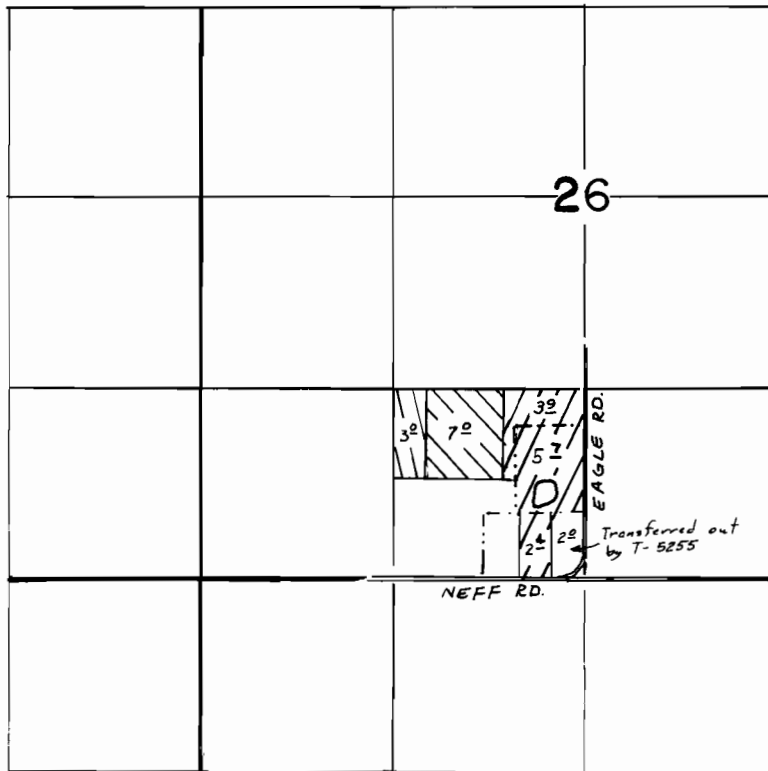
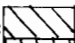


T.17S.,R.12E.,W.M.

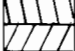

SCALE: 1" = 1320'

FINAL PROOF SURVEY UNDER

Transfer M-140c  1 of 4
 2848
 Cert. 29052 

IN NAME OF

.....ROBT. H. FOLEY.....

Surveyed JUNE 24 19.85., by L. OLSON.....