


T.13S.,R.33E.,W.M.

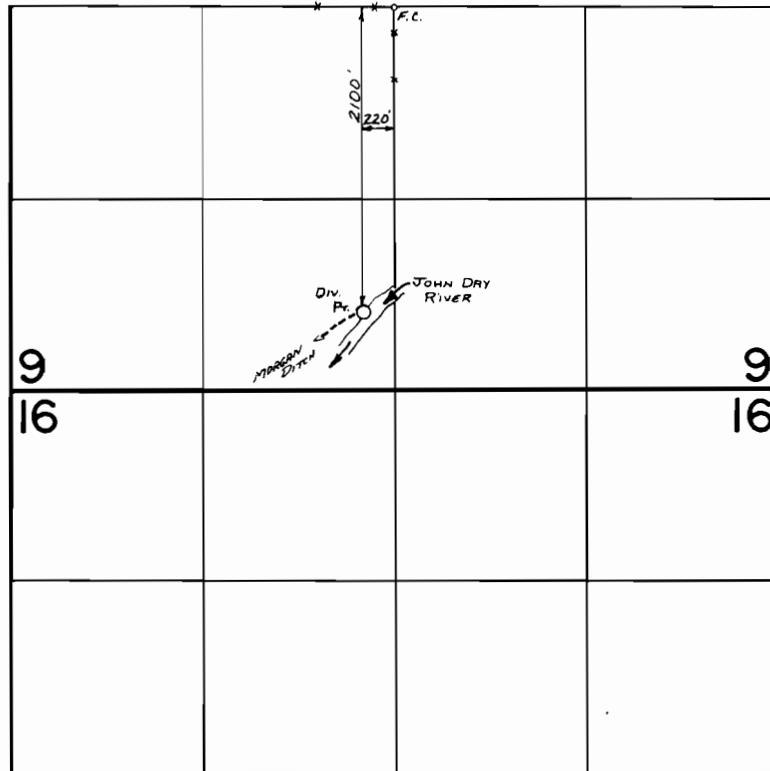

**FINAL PROOF SURVEY**  
UNDER

Transfer No. M-147  
Application No. \_\_\_\_\_ Permit No. \_\_\_\_\_  
IN NAME OF

MRS. ART MORGAN

Surveyed AUG. 8. 1972. by D. NORBY