


T. 2S., R. 32E., W.M.

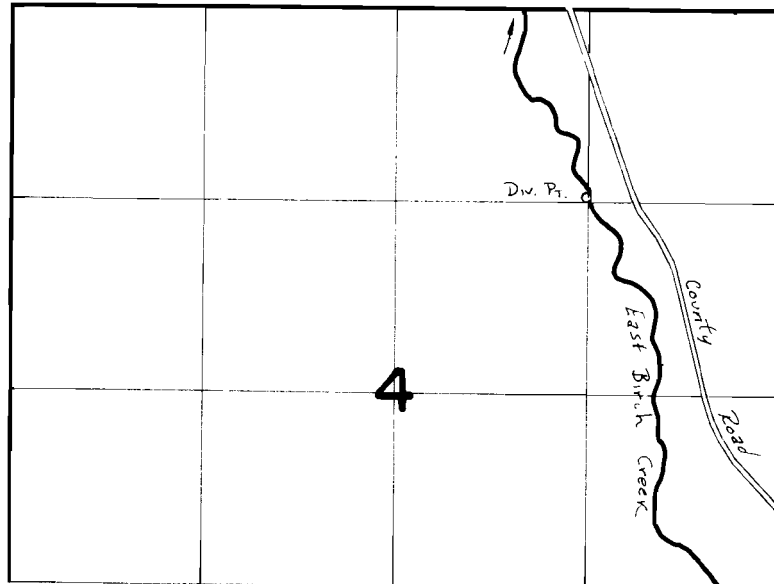

SCALE 4" = 1 MILE



Div. Pt. Loc: 1300'S. & 1340'W. FROM NE COR. SEC. 4

FINAL PROOF SURVEY
UNDER

TRANSFER M-151

IN NAME OF

A. R. M^cBROOM

Surveyed 1-25 1984, by V. L. Church