


E. F. McDole
Rt. 1, Box 183
Hermiston, Oregon 97838

Well # 4
Map showing change in point of diversion.

Scale 1" = 660'

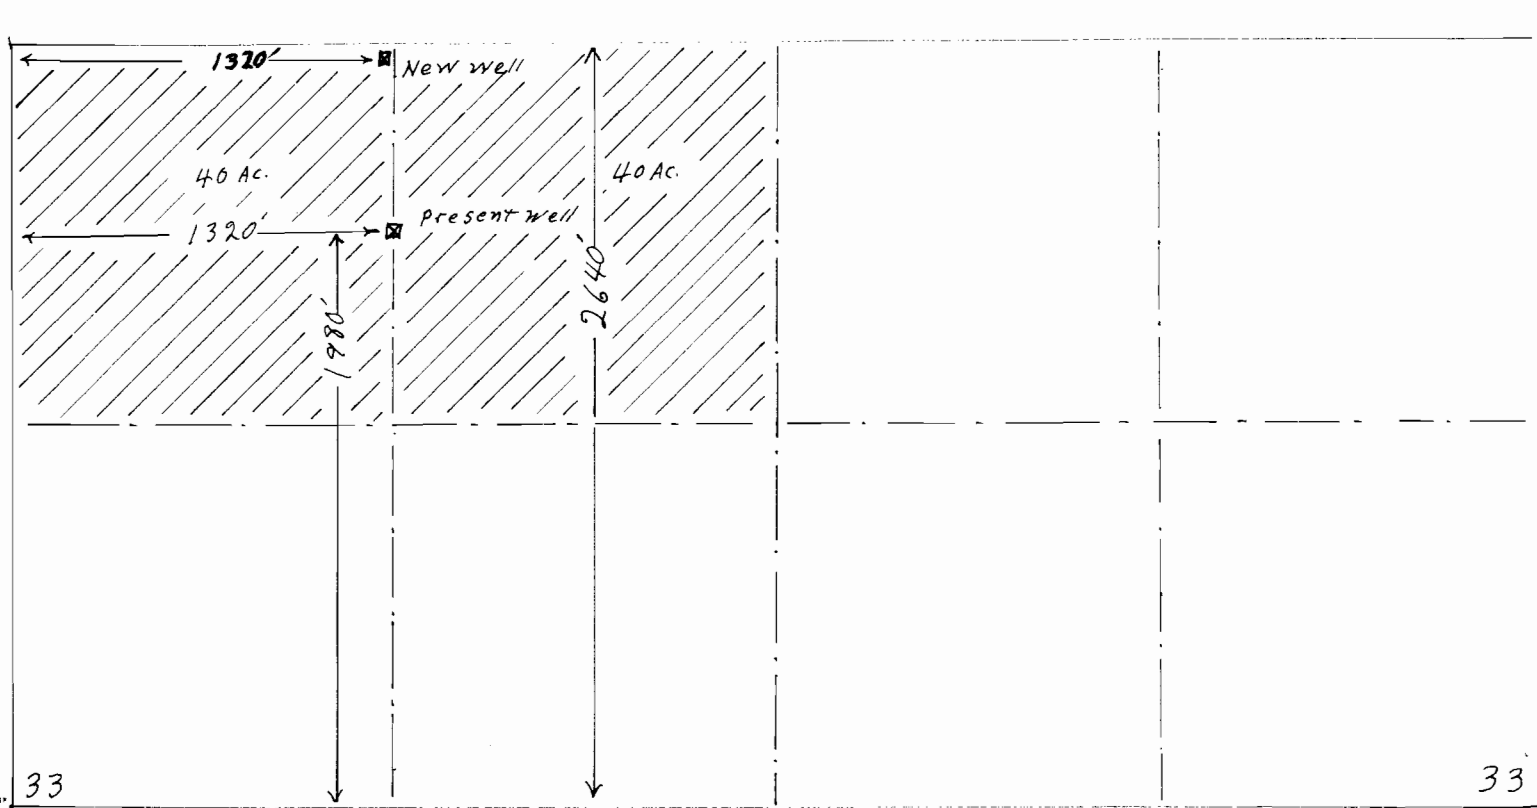

S.W. Corner Sec. 33, T4N; R27E, W.M.