


T.39S. R.5W. W.M.

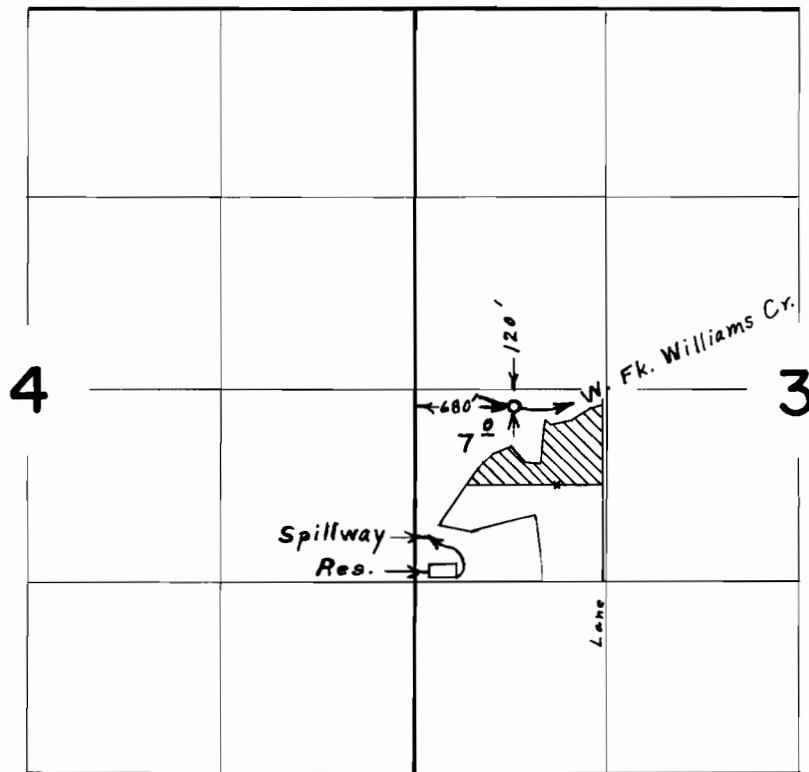

FINAL PROOF SURVEY
UNDER

Application No. _____ Transfer No. M-162
Permit No. _____

IN NAME OF

MARJERY W. OVERACKER

Surveyed *May 23, 1975*, by *L. E. Gould*