


# T.8&9S.R.25E.W.M.

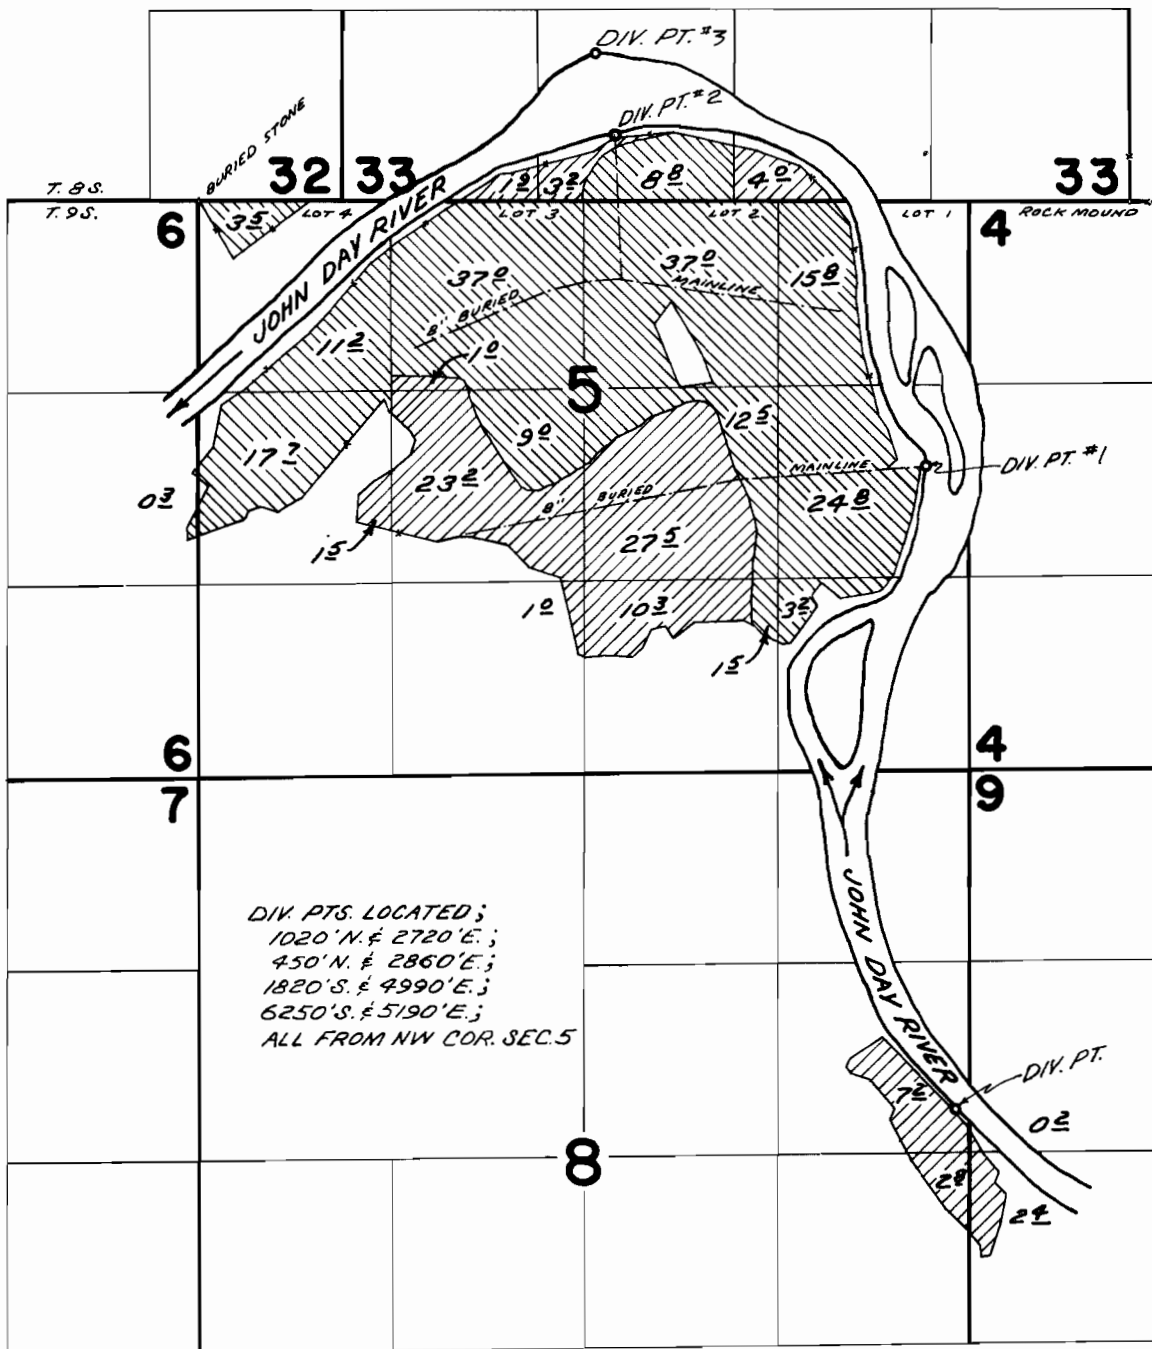

## FINAL PROOF SURVEY UNDER

L-100 &  
TRANSFER No. M-165  
Application No. 44149 Permit No. 32864 

IN NAME OF

**ANDREW F. & MAXINE F. LECKIE**

Surveyed FEB 9-11 1970, by D. BUELL