


T. 36 S. R. 1 W. W. M.

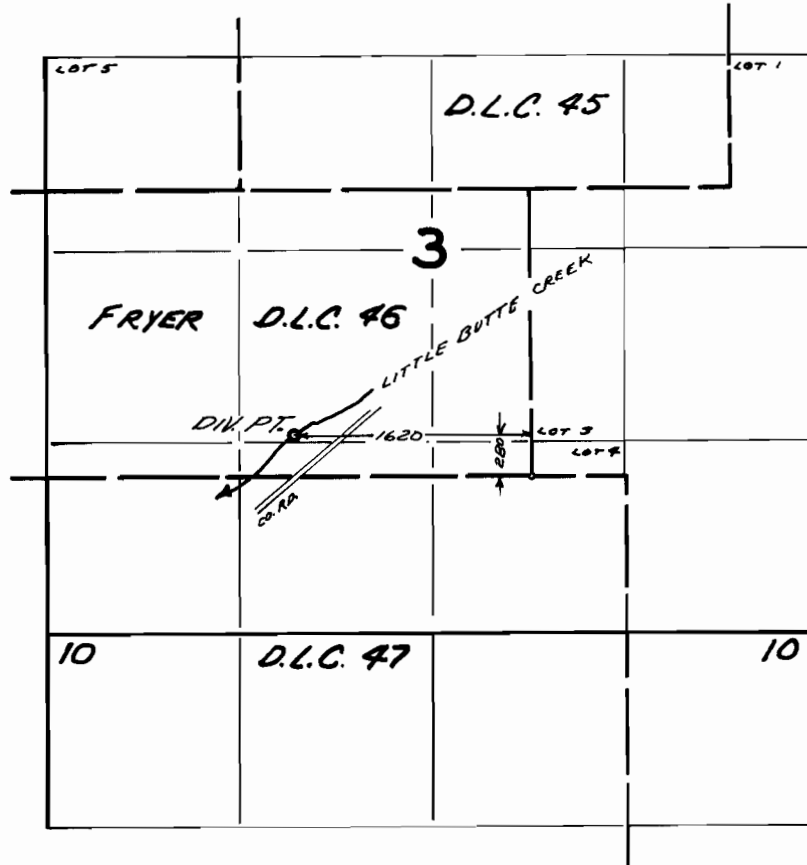

**FINAL PROOF SURVEY**  
UNDER

TRANSFER M-166  
Application No. .... Permit No. ....  
IN NAME OF

*JAMES L. AND MARIE D. MITCHELL*

Surveyed *JUN. 5*, 1968, by *V. GARNER*