


T. 36S. R. 4 W. W.M.

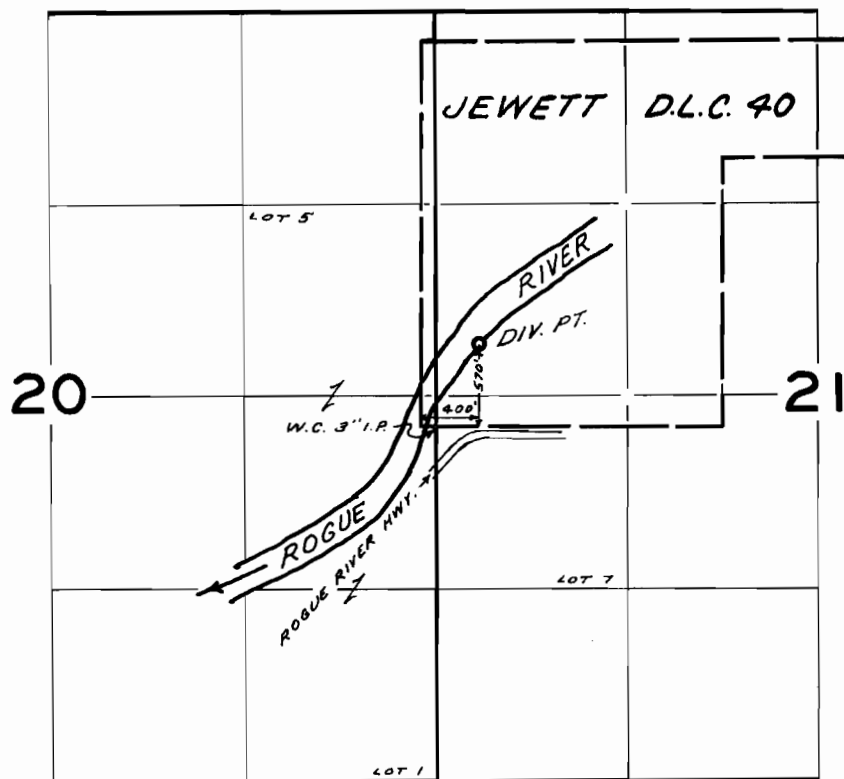

**FINAL PROOF SURVEY**  
UNDER

TRANSFER No. M-168  
Application No. .... Permit No. ....

IN NAME OF

*THOMAS V. AND CORA A. MOODY*

Surveyed JUN 4 1968, by V. GARNER