


T. 5 S. R. 1 E. W. M.

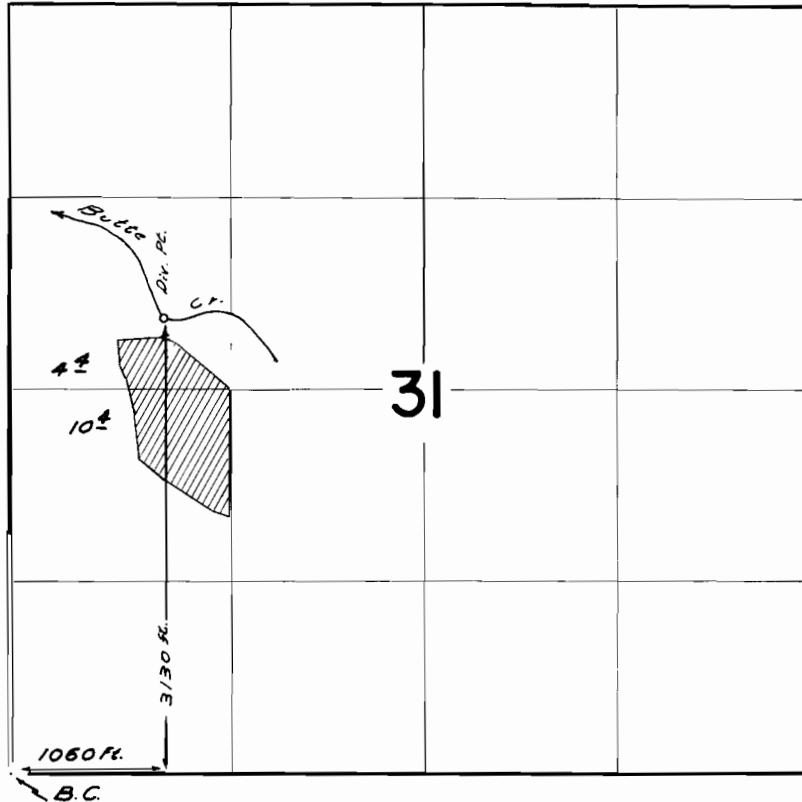

FINAL PROOF SURVEY
UNDER

Application No. **34481** Permit No. **27079**
IN NAME OF

ALMA & CLARENCE L. MEDACK

Surveyed **OCT. 21, 1965**, by **L. COLEBANK**