


# T. 1 N. R. 3 W. W. M.

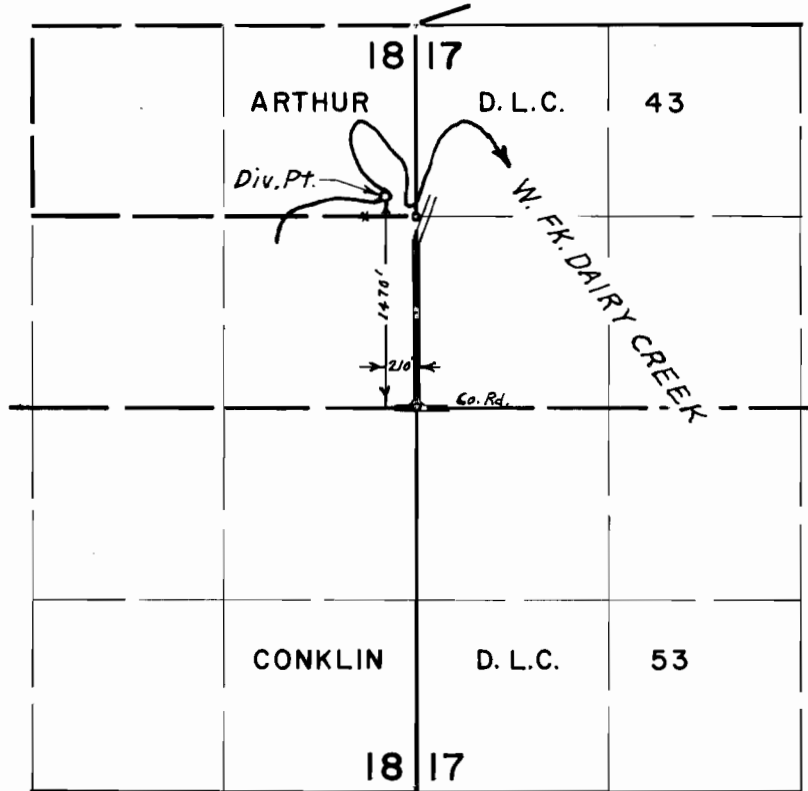

## FINAL PROOF SURVEY UNDER

Application No. \_\_\_\_\_ Transfer M-176  
Permit No. \_\_\_\_\_

IN NAME OF

**DANIEL B. MOORE**

Surveyed May 28, 1971, by L. E. Gould