


T.1N. R.4W. W.M.

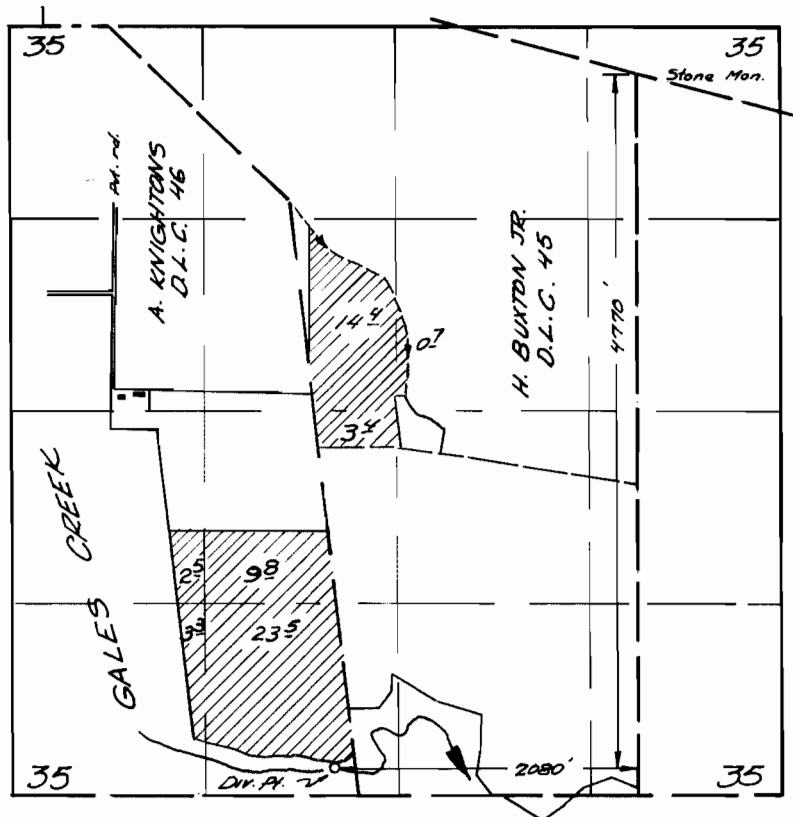

FINAL PROOF SURVEY UNDER

Application No. TRANSFER M-180 Permit No. _____

IN NAME OF

W.G. KRIEGER by DALE McCULLOCH

Surveyed Jan. 18, 1968, by V. Garner