


T. 1 S. R. 13 E. W. M. .

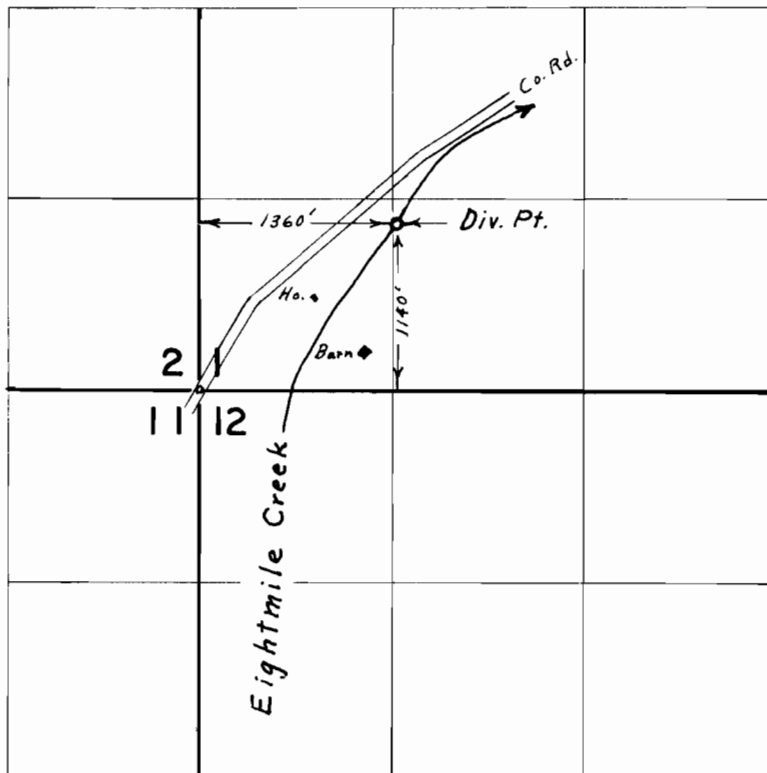

FINAL PROOF SURVEY UNDER

Application No. _____ Transfer M-181
Permit No. _____

IN NAME OF

FRANK K. MAY

Surveyed Nov. 11, 1971, by L. E. Gould