


T. 35 S. R. 4 W. W. M.

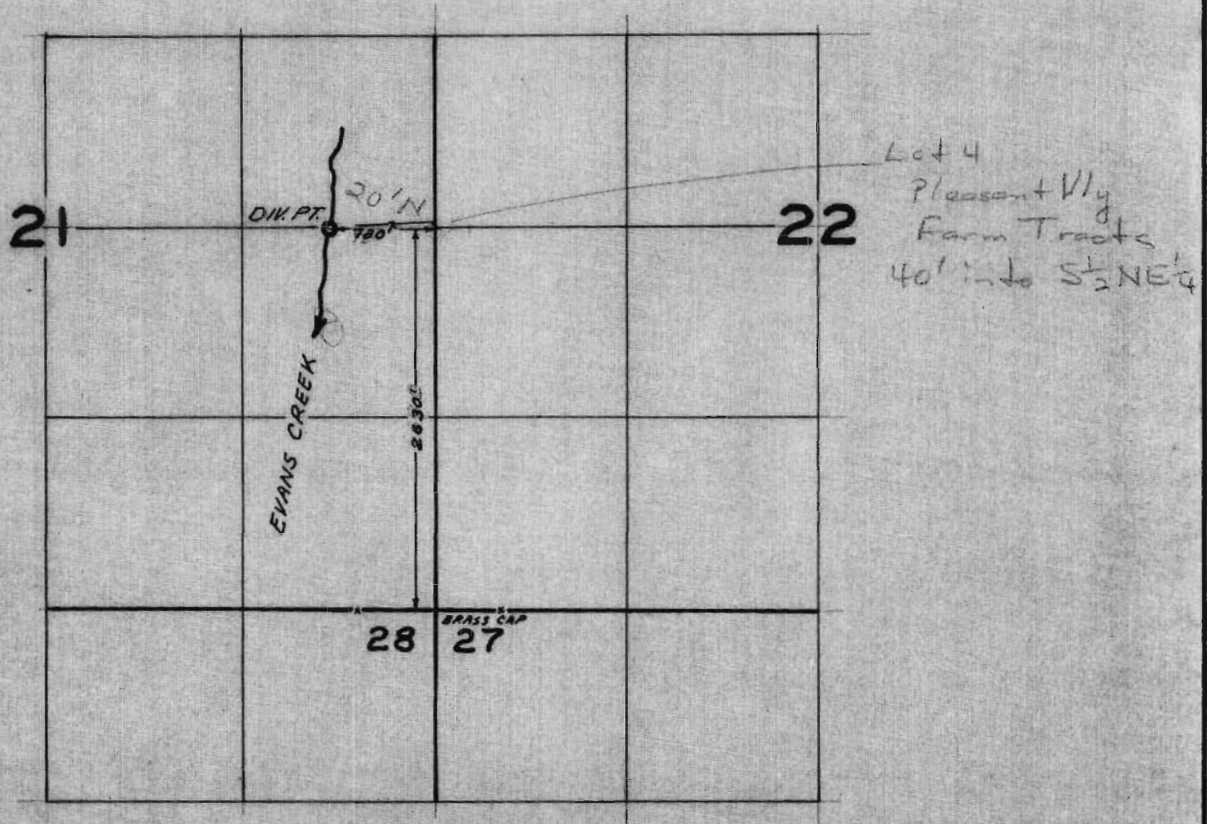

**FINAL PROOF SURVEY**  
UNDER

TRANSFER No. M-184  
Application No. .... Permit No. ....  
IN NAME OF

**EUGENE L. MARS**

Surveyed JUN 6, 1968, by K. GARNER