


T.30S.,R.4W., W.M.

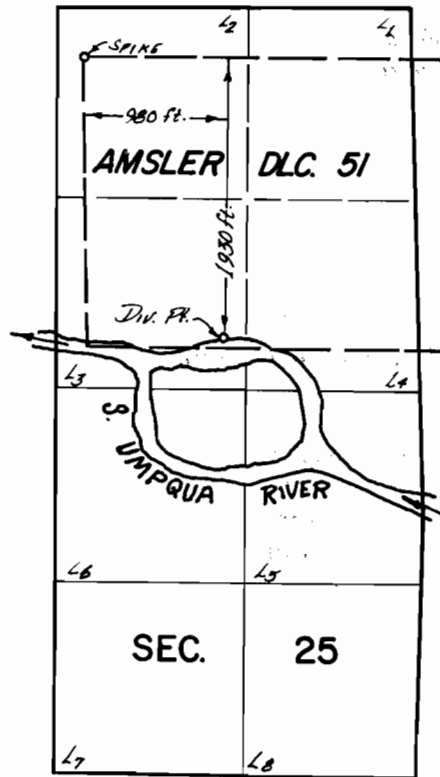

FINAL PROOF SURVEY
UNDER

TRANSFER M-187

Application No. Permit No.

IN NAME OF

.....ARTHUR C. MILLER.....

Surveyed 26 JUNE 1969, by L. E. GOULD