


T. 14 S. R. 8 W. W. M.

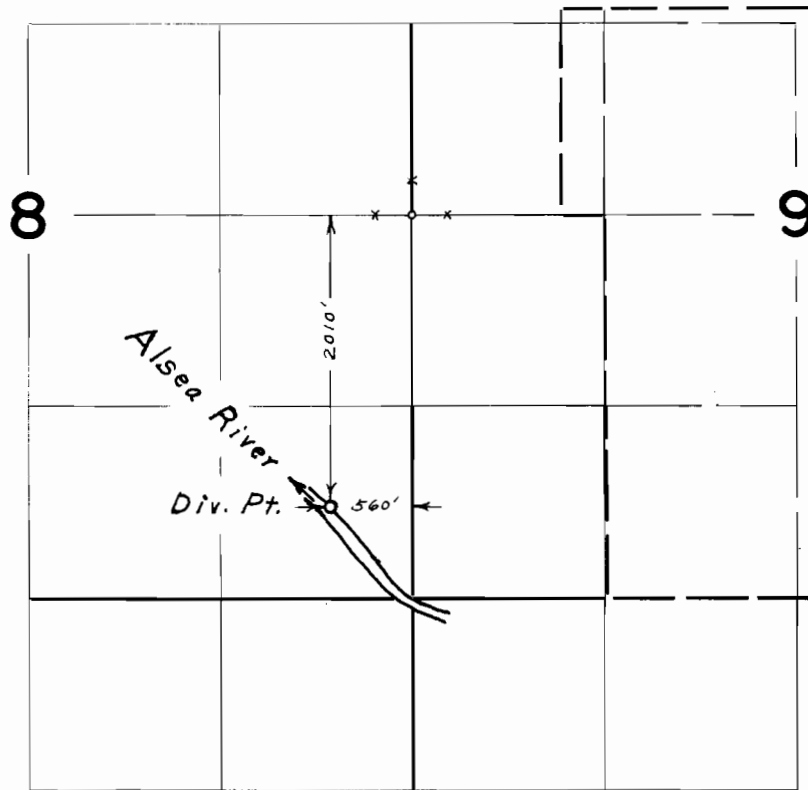

FINAL PROOF SURVEY
UNDER

Application No. _____ TRANSFER NO. M-206
Permit No. _____
IN NAME OF

WILBUR W. MALTBY

Surveyed Sept. 9, 1970, by L. E. Gould