


T.40S.,R.8W.,W.M.

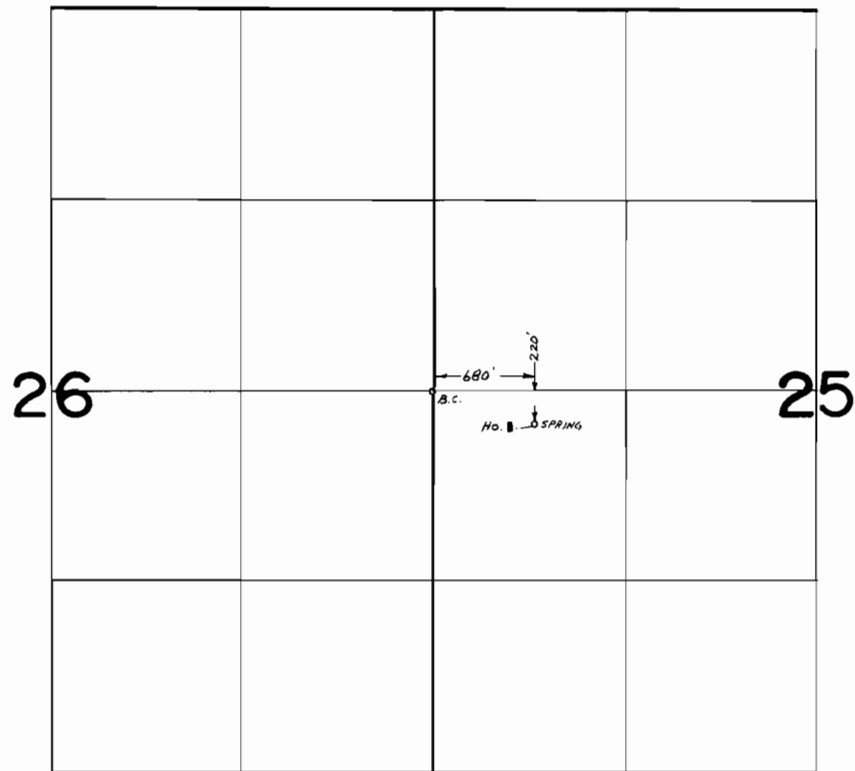

**FINAL PROOF SURVEY**  
UNDER

Transfer No. M-208 Permit No. ....  
Application No. .... IN NAME OF

..... CORAL M. MORRIS .....

Surveyed *May 1* 19 *75*, by *L. Tell* .....