


# WATER RIGHTS MAP - SKUNK CR.

SEC. 30 TWP 18 S. RGE. 11 W. W.M.

1 INCH = 200 FEET

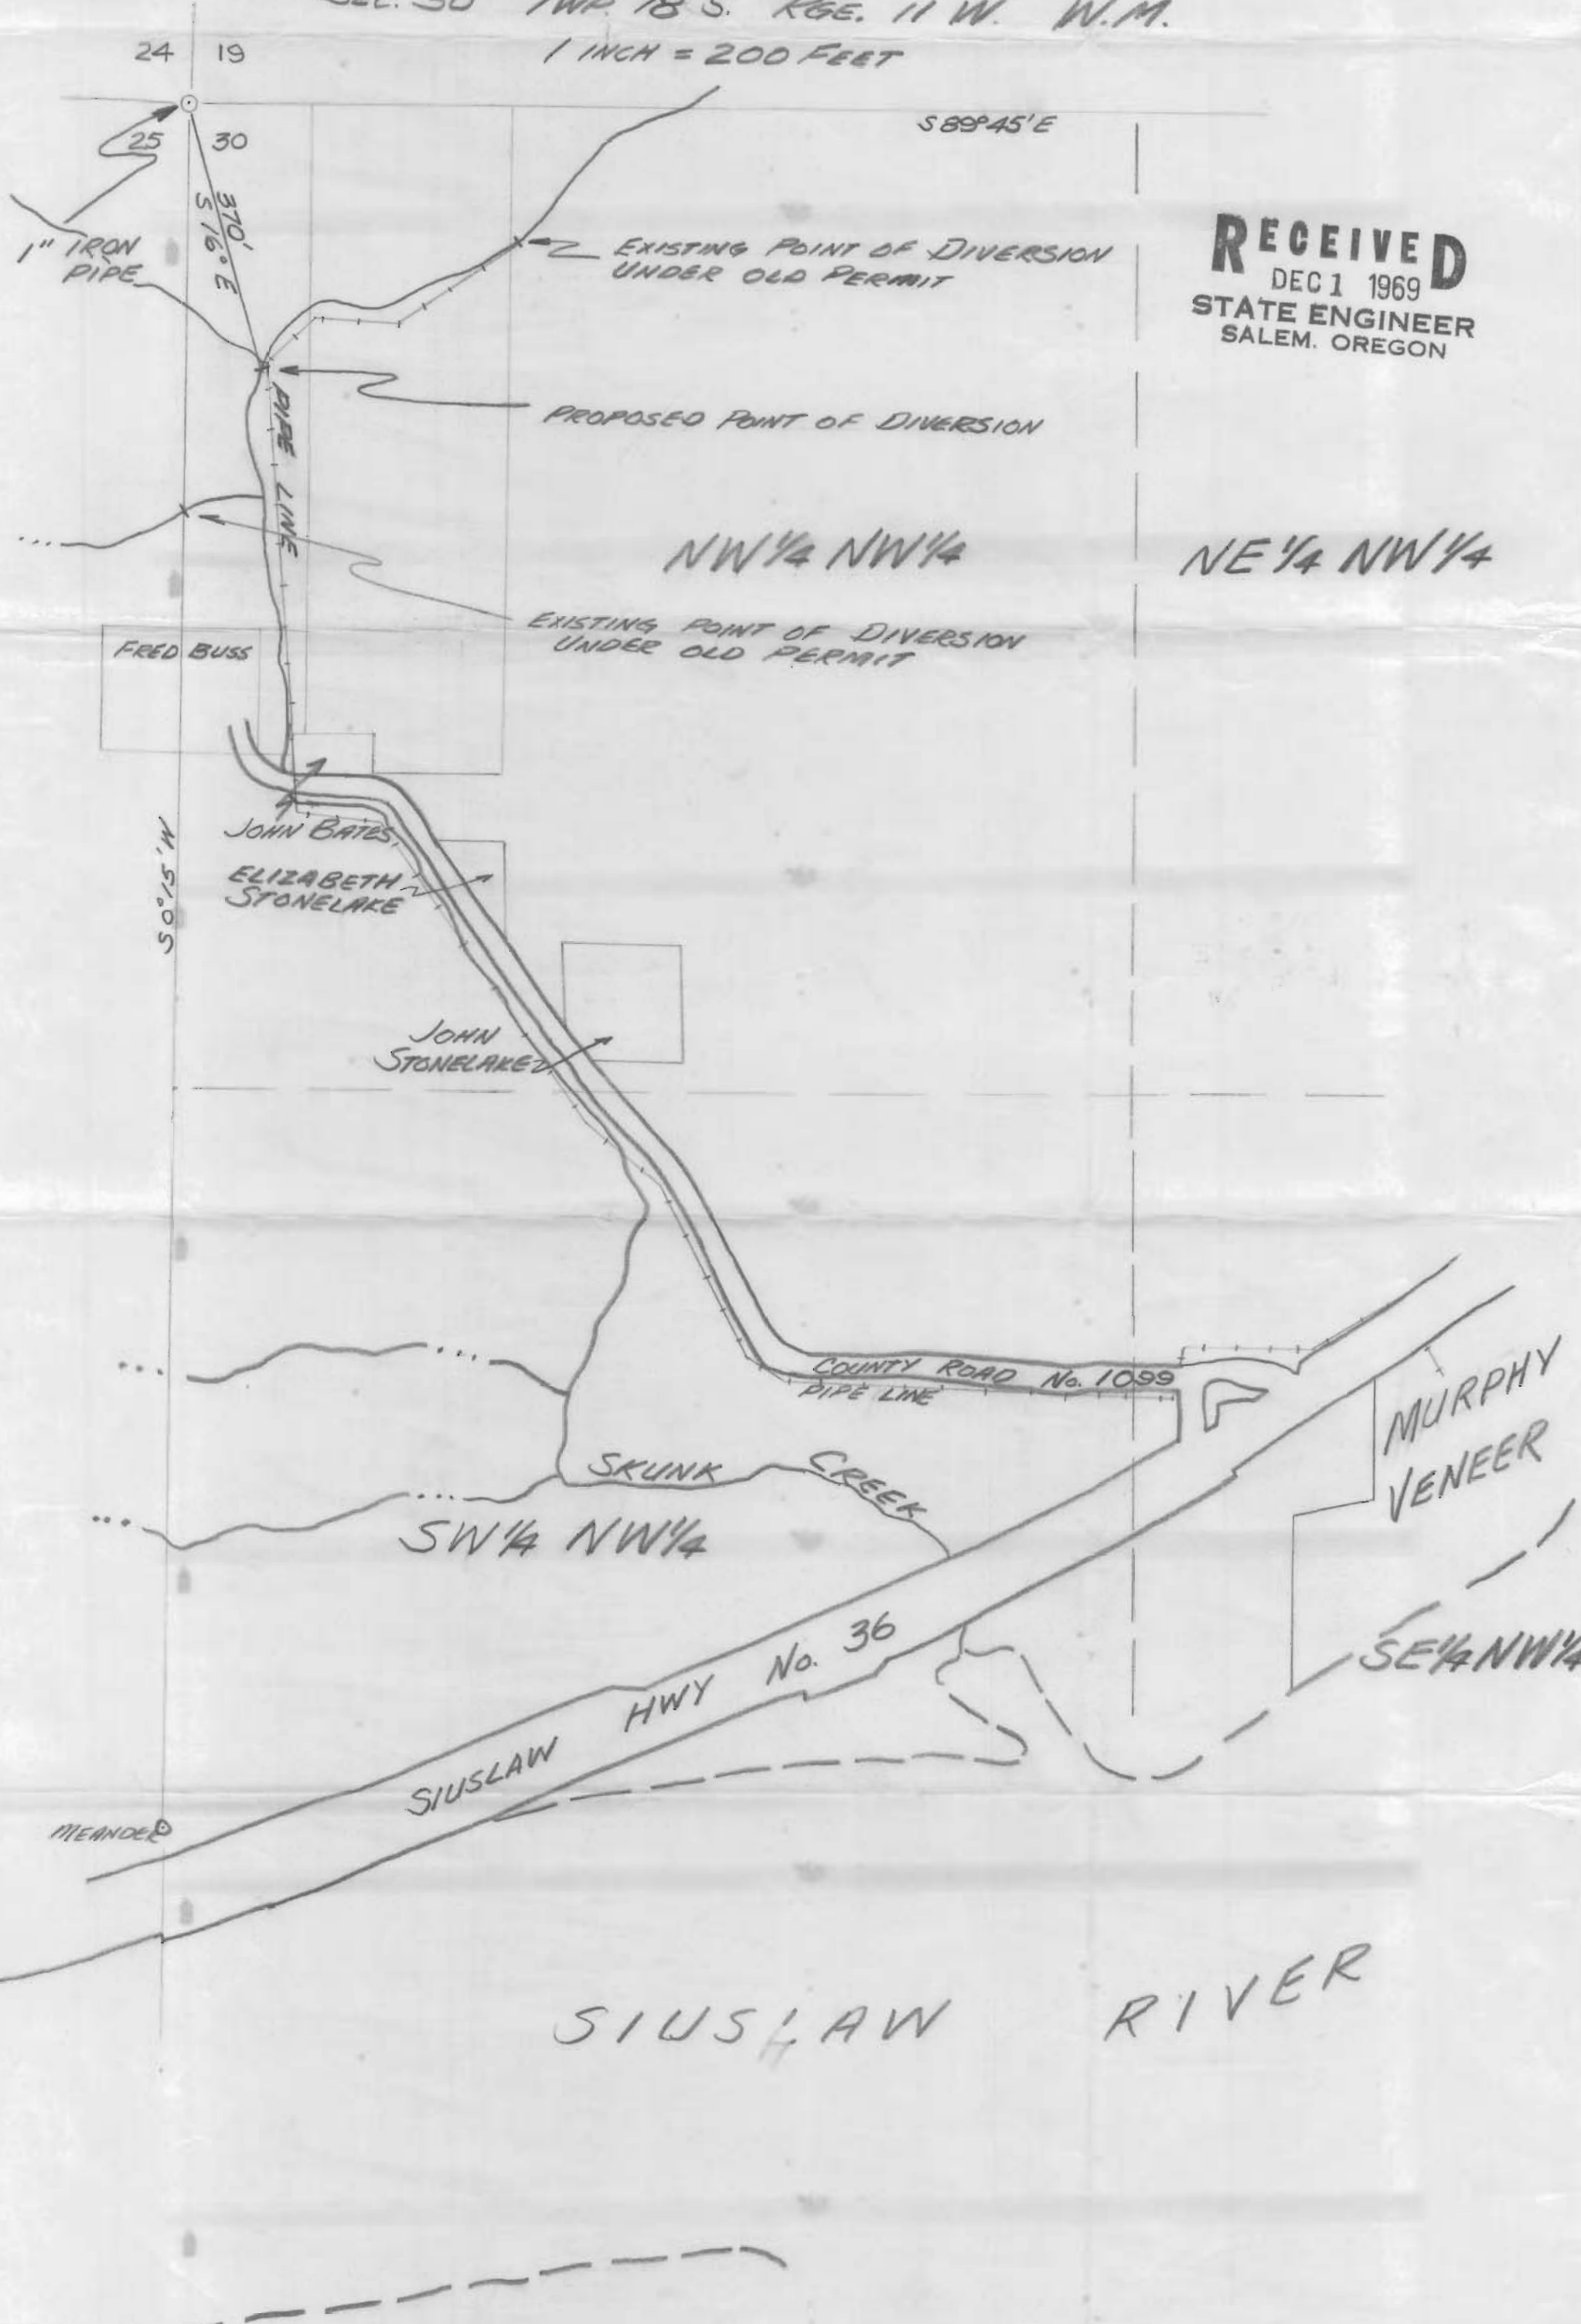

**RECEIVED**  
DEC 1 1969  
STATE ENGINEER  
SALEM, OREGON