


T.5 S R.11 E.W.M.

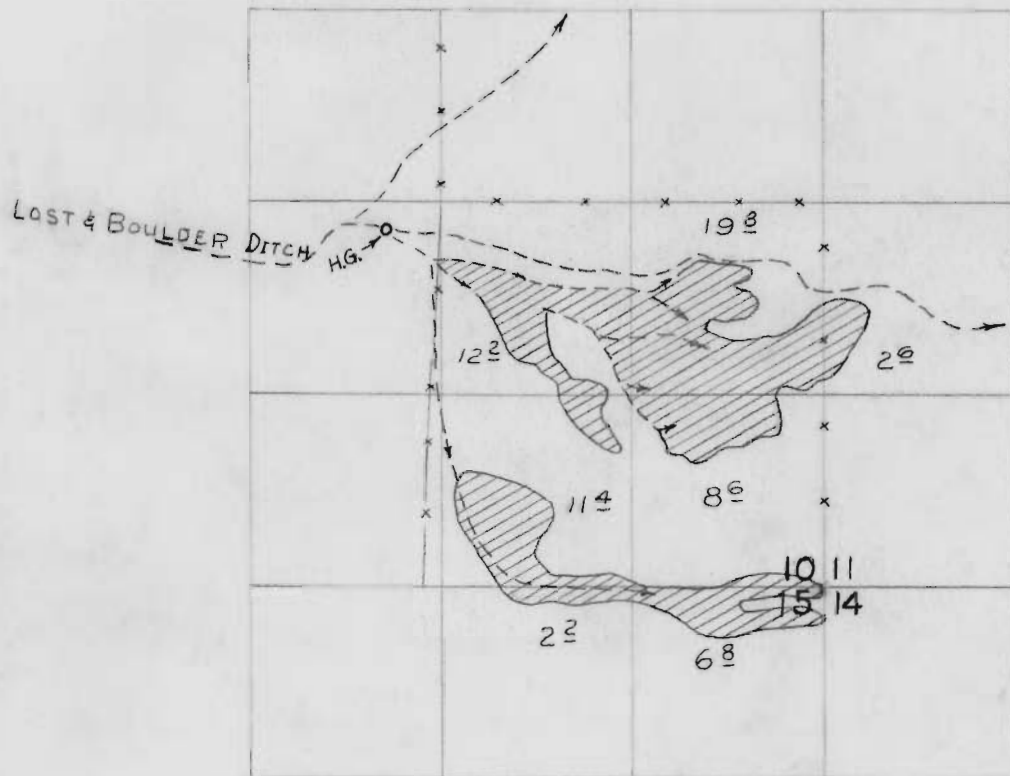

TRANSFER No. N-13

GEORGE W. & LUCILLE P. NELSON

Surveyed 10 Nov. 1959 by *W. Bich*