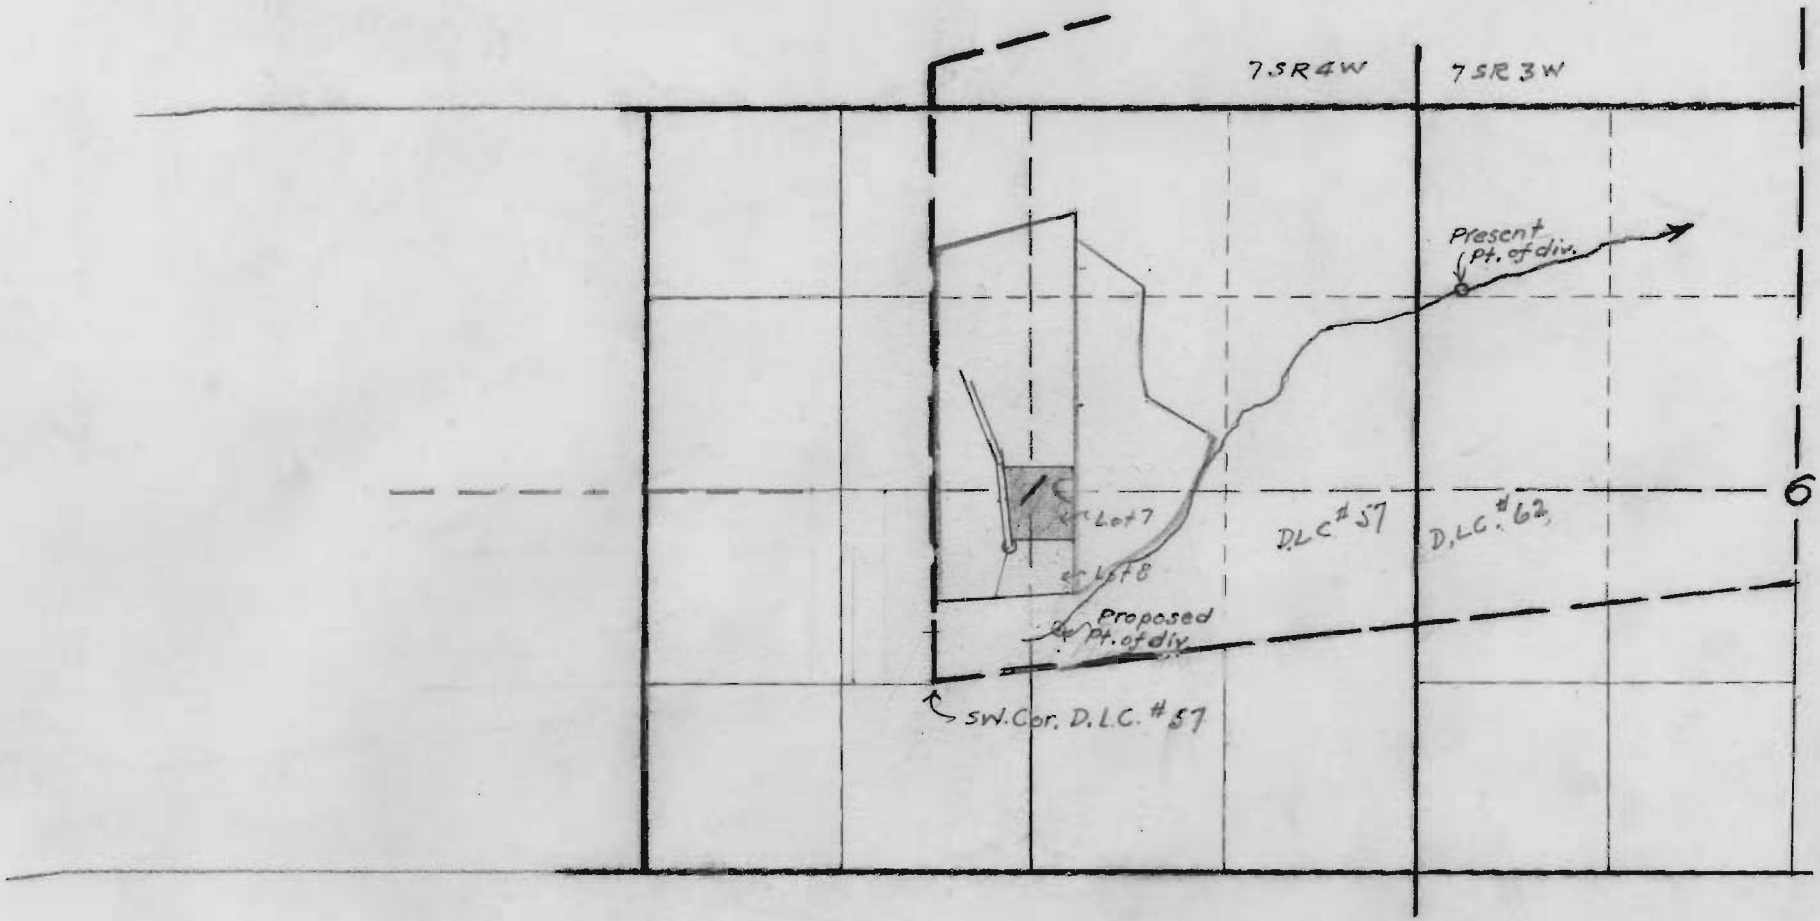
7 S R 4 W
7 S R 3 W
Present Pt. of div.
Lot 7
Lot 8
D.L.C. # 57
D.L.C. # 62
Proposed Pt. of div.
SW. Cor. D.L.C. # 57
6