


T.17S.,R.12E.,W.M.

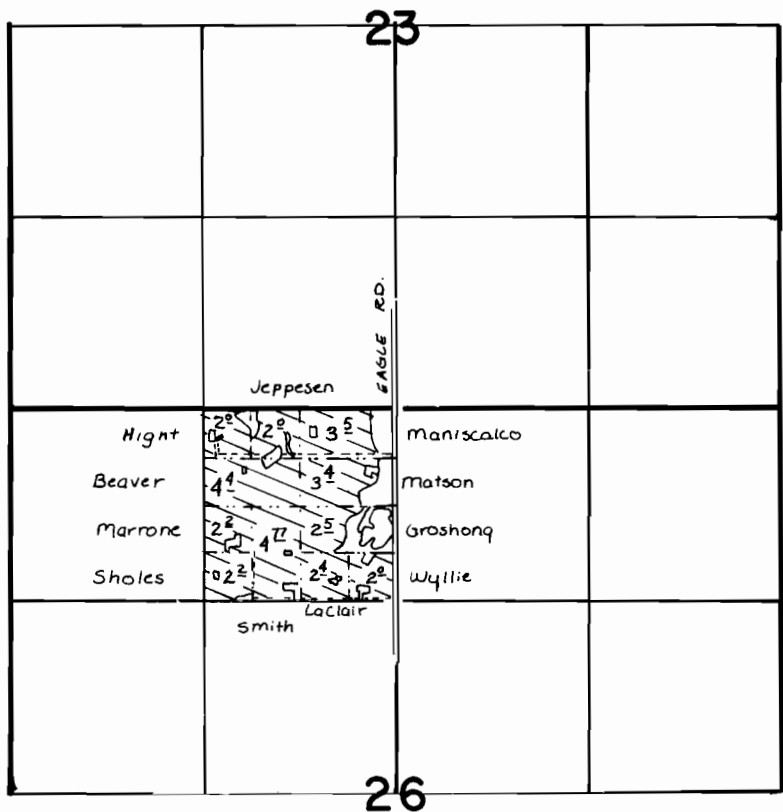

SCALE: 1" = 1320'

FINAL PROOF SURVEY UNDER

Transfers K-36,
P-63, N-27

IN NAME OF

SHOLES, et. al.

Surveyed MAY 3, 1966, by W.J. RUPPERT